State W	ell Renort	
	State Well Report	
County: <u>Franklin</u> Mississippi Department	Mississippi Department of Environmental Quality	
	nd Water Resources	Well #: <u>M-24</u>
Driller: Oary Ray Dorn Jackson, M	IS 39289-0631	L. S. Elevation:
	961-5210 4-6938 (fax)	E-log #:
		the the Department within
State Law requires that this report be prepared by the 30 days of completion of drilling of the well.		· · · · · · · · · · · · · · · · · · ·
Well Owner Information		l Location
Owner Name Kepco Operating Co	Latitude:°'	_" Longitude:''
Mailing Address: 4415 N, Classen Blvd	Method of Lat/Long (circle o	ne): Conventional Survey,
	USGS quad; Hand-held	d GPS, Survey-grade GPS
OKCITY OK 73118 City State Zip Code	1414 Sec.30	<u>Twn 5N Rng ZE</u>
City State Zip Code	Distance Direction	of KOOXVILLE, MS
Telephone No. (405) 525 - 1793	<u>5</u> Miles Ecist	of Knoxville MS
Well		$\bigcirc$
Purpose of Well (circle one) Home Industrial Public Supply	Irrigation Fish Culture	(Other:) Rig Supply
Date well drilling started: <u>3-22-08</u> Date	well drilling completed:	3-22-08
	·	
If flowing, method of flow regulation: Valve Other (		3.12-08
Static Water Level: <u>60</u> feet above of below (circle one)		
Method of Measurement (circle one) steel tape electric tape		
Hole depth: 200' Well depth: 200'	_ Well grouted to a depth of	<u> </u>
Type of grout (circle one): Cement Bentonite Mix		0
Casing length: _ 180_feet Casing diameter:	inches Type of casing:	PVC
Screen length: <u>20</u> feet Screen diameter: <u>4</u>	inches Type of screen:	PVC
Screen slot size: <u>1020</u> inches Setting depth: From		
Type of completion (circle all applicable): Gravel packed Under		
Top of lap pipe or reduction in casing:feet. If		
Logs run (circle all applicable): No log run Electric Gamma Ra		
Name of organization running log(s): I certify that the well was drilled, constructed, and completed in	accordance with all applicab	le requirements of the Mississippi
Department of Environmental Quality and/or the Mississippi D	epartment of Health regulatio	ns and state laws.
	) –	
RAYBORN DRILLING, INC. 0-60	<b>Simulation</b>	of Water Well Contractor
Print Name of Water Well Contractor and License No.	Signature	

.4

-

BY: OLMP

M-24

RECEIVED

APR 17 2008


BY: OLWR

If well telescopes please sketch below and show depths.



Description of Formations Encountered	From	10
	+ n	40
Clay		10
Fine Sand	40	70
Clay	70	150
Clay SAND	150	200
		<b> </b>

If more than one screen, show location of each on sketch

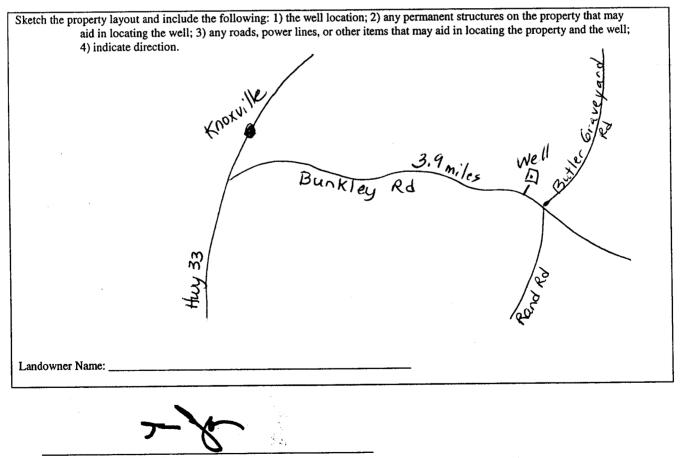

Signature of Water Well Contractor

County: <u>Franklin</u> Permit #: Driller: <u>Gary Rayborn</u> Date completed: <u>32208</u> This report should be prepared by the p installation of pump. Well Owner Information	Pa Pump Installer's Mississippi Department Office of Land au P.O. B Jackson, M	LL REPORT art 2 Completion Report of Environmental Quality and Water Resources ox 10631 S 39289-0631 961-5210 4 6028 (for)	For Office Use Only: Aquifer: Well #: <u>M-29</u>
Permit #: Driller: <u>Gary Rayborn</u> Date completed: <u>32208</u> This report should be prepared by the p installation of pump.	Mississippi Department Office of Land an P.O. B Jackson, M (601)9	t of Environmental Quality nd Water Resources ox 10631 S 39289-0631 961-5210	Well #: <u>M-29</u>
Date completed: 32208 This report should be prepared by the p installation of pump.	(601)9	961-5210	
This report should be prepared by the p installation of pump.	(001)334		Elevation:
installation of pump.			
			ll Location
Dwner Name: Kepco Operati Mailing Address: 4415 N. Cla	Latitude: Lassen Blvd Method of Lat/Long (circle on USGS quad, Hand <u>USGS quad, Hand</u> <u>USGS quad, Hand</u> <u>USGS quad, Hand</u> <u>USGS quad, Hand</u> <u>USGS quad, Direction</u>		Longitude:
Mailing Address: 4415 N. C.la			ne): Conventional Survey,
OKCity OK			nd-held GPS, Survey-grade GPS
City   State Telephone No. ( <u>405) 525 - 179.</u>			Nearest Town of <u>Knoxville, MS</u>
Telephone No. ( <u>10)</u> 000 7 7 7	<u></u>		
Pump Type Circle one			ower Type Circle one
Air Lift Jet	Submersible		ine Engine Natural Gas
	Turbine C	Electric Motor Hand	
	Flowing Well		r (specify): pr:54P
Other (specify): Date Pump Installed: 322 02	8	Setting Depth:	
1 -	Gallons Per Minute	Number of Stages:	11
Pump Test Data			feasuring Water Level
Date Well Tested: 32208		6	Circle one Steel Tana
	elow Land Surface		easuring Line Steel Tape
Pumping Water Level (B):Feet Be			
Drawdown [(B) – (A)]:Feet B	Below Land Surface	For flowing well, measured Well yielded $\underline{QO}$	shut in head:feet GPM with a drawdown of
Test Pumping Rate:C		well yleided	hours of pumping