

**FRANKLIN MISSISSIPPI BOARD OF WATER COMMISSIONERS**

**8-19-60** **CODED** **WATER WELL DRILLERS LOG** **M-300**

Date: 8-19, 1960, Driller: Herring Lemight Inc. County Franklin  
(Name)

(1) Owner of Land: A. J. Duines  
(Name)  
Rt. 2, Mendville, Miss.  
(Address)

(2) Location: 1/4, 1/4, Sec. 34 T5 R2  
5 1/2 miles South, of Mendville.  
(distance) (direction) (Nearest Town)

(3) Topography: Hilly  
(Hilly) (Flat) (Level)

(4) Purpose of Well: Domestic  
(Domestic Irrigation Municipal, Industrial, Other)

Description & Color of Materials Sand, Clay, Red Clay, Shell, etc.	Thick- ness Feet	Depth Feet
<u>Sand &amp; Pea Gravel</u>	<u>20'</u>	<u>20'</u>
<u>Clay</u>	<u>20'</u>	<u>40'</u>
<u>Sand</u>	<u>10'</u>	<u>50'</u>
<u>Clay</u>	<u>100'</u>	<u>150'</u>
<u>Sand</u>	<u>46'</u>	<u>196'</u>

Information upon completion of well:

(1) Diameter 4 3/4 inches.

(2) Total Depth 196' feet.

(3) Water Level 55' feet below top of ground.

(4) Cased to 191', Size 2"

(5) Screen: Size 2", Length 5'

(6) Were any formations sealed against pollution?  
 \_\_\_\_\_ yes,  no.


If YES depth of formation \_\_\_\_\_

Why \_\_\_\_\_

Drillers Remarks: \_\_\_\_\_

*Either dist. or direct are off or range should be 3E. RN*

**CODED**

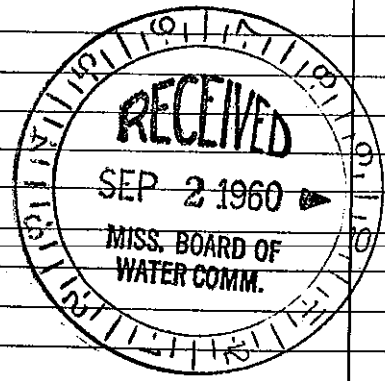

Well No.

(Use Back Side)

Mail this copy to Board of Water Commissioners 429 Miss. St. Jackson, Miss.