

FRANKLIN MISSISSIPPI BOARD OF WATER COMMISSIONERS

N3
7-26-60

CODED

WATER WELL DRILLERS LOG

N 301


Date: 7-26, 1960, Driller: Chester Reeves
Reeves Well & Pump Co. County: Franklin

(1) Owner of Land: <u>W. B. McManus</u> (Name) <u>RD 3, Meadville</u> (Address)	Description & Color of Materials Sand, Clay, Red Clay, Shell, etc.	Thick- ness Feet	Depth Feet
(2) Location: $\frac{1}{4}$, $\frac{1}{4}$, Sec. <u>34</u> <u>SR 3</u> <u>South</u> <u>7</u> miles <u>East</u> of <u>Bude</u> (distance) (direction) (Nearest Town)	<u>White Clay</u>	<u>12</u>	<u>12</u>
(3) Topography: <u>Level</u> (Hilly) (Flat) (Level)	<u>Fine white sand</u>	<u>33</u>	<u>45</u>
(4) Purpose of Well: <u>Domestic</u> (Domestic Irrigation Municipal, Industrial, Other)	<u>Coarse sand & small pea gravel</u>	<u>5</u>	<u>50</u>

Information upon completion of well:

- (1) Diameter: 2 inches.
- (2) Total Depth: 50 feet.
- (3) Water Level: 18 feet below top of ground.
- (4) Cased to: Bottom, Size 2"
- (5) Screen: Size 1 1/4, Length 6'
- (6) Were any formations sealed against pollution?
_____ yes, no.

If YES depth of formation _____
Why _____
Drillers Remarks: _____

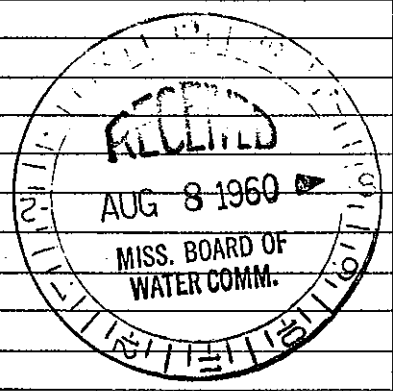

CODED

Well No.

(Use Back Side)

Mail this copy to Board of Water Commissioners 429 Miss. St. Jackson, Miss.