

Franklin
N 6
7-68

MISSISSIPPI
BOARD OF WATER COMMISSIONERS
416 North State Street
Jackson, Mississippi 39201

CODED

WATER WELL DRILLERS LOG

JULY 6 1968 Central Cont. Co. FRANKLIN
date well completed firm name county well located

LANDOWNER: BLACK OIL CO

description of formations encountered

from to

JUSTICE MEARS
(mailing address)

SHALE	0	15'
SAND	15'	90'
SHALE	90'	217'
SAND	170'	260'
SHALE	260'	263'
SAND	263'	325'

WELL LOCATION:

sec. 22 T. 5 N R. 3 E

10 miles E of KNOXVILLE
(distance) (direction) (nearest town)

WELL PURPOSE: SUPPLY
(home, irrigation, municipal, industrial)

WELL COMPLETION DATA:

(1) diameter (inches) 3"
(2) total depth (feet) 325'
(3) static water level (feet) 90' below above top of ground.

(4) casing STEEL, 305'
(material) (depth)

(size) if telescope see back.

(5) screen 20', 305'
(length) (depth to top)

3", SLOTTER PIPE
(size) (material)


(6) pump 4 IN —
(HP) (yield gpm)

BUTANE
(type power)

(7) electric log NO
(yes or no)

(organization running log)

(8) how well bottom plugged puddled CLAY

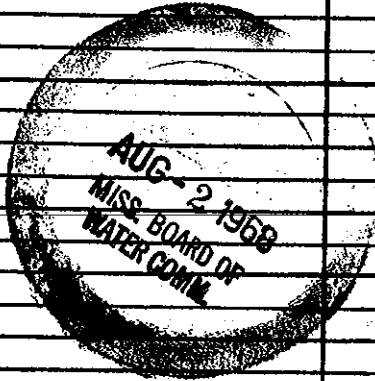

DRILLERS REMARKS: