

CODED

Franklin
01
3-67
Elec Log

MISSISSIPPI
BOARD OF WATER COMMISSIONERS
416 North State Street
Jackson, Mississippi 39201

WATER WELL DRILLERS LOG

3-1 1967 Layne-Central Co. Franklin
date well completed firm name county well located

LANDOWNER: Sixtown Water Association, Inc

(mailing address)

WELL LOCATION:
sec. 28 T. 5 N. R. 4 E
10 miles South of Bude
(distance) (direction) (nearest town)


WELL PURPOSE: DOMESTIC
(home, irrigation, municipal, industrial)

WELL COMPLETION DATA:

- (1) diameter (inches) 8"
- (2) total depth (feet) 253'
- (3) static water level (feet) 142' below top of ground.
- (4) casing 8" 210'
(material) (depth)
8" If telescope see back.
(size)
- (5) screen 40' 210'
(length) (depth to top)
6" Stainless Steel
(size) (material)
- (6) pump 10
(HP) (yield gpm)
Electric
(type power)
- (7) electric log YES
(yes or no)
MISS. GEO. SURVEY
(organization running log)
- (8) how well bottom plugged VALVE

description of formations encountered	from to	
Top Soil	0	2
Yellow Clay	2	17
SAND AND GRAVEL	17	52
White Clay	52	80
SAND	80	89
Sandy Clay	89	105
SAND	105	130
Sandy Clay	130	140
Clay	140	176
Sandy Clay	176	202
SAND	202	251
Clay	251	254

CODED

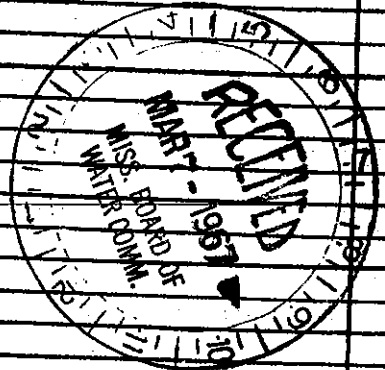

DRILLERS REMARKS:
Pump Not installed -
TEST to be RUN AT A
LATER date.