

FRANKLIN

CODED

F02

MISSISSIPPI BOARD OF WATER COMMISSIONERS

3-11-66

WATER WELL DRILLERS LOG

Date: 3-11, 1966, Driller: Chester Reeves County Franklin

(1) Owner of Land	Description & Color of Materials Sand, Clay, Red Clay, Shell, etc.	Thick- ness Feet	Depth Feet
M. W. Luff Rt 3. Madville	Red clay Soft yellow sand with gravel	25	25
(2) Location: 1/4, 1/4, Sec. 15 T. 5 R. 4	gravel	60	85
6 miles East of Madville	white chalk	65	150
(3) Topography: Hilly	fine silt sand	10	160
(4) Purpose of Well: Domestic	coarse clean sand	17	177

Information upon completion of well:

(1) Diameter 4 inches.

(2) Total Depth 177 feet.

(3) Water Level 160 feet below top of ground.

(4) Cased to Bottom Size 4'

(5) Screen: Size 4', Length 6'

(6) Were any formations sealed against pollution?
 yes, no.

If YES depth of formation _____


Why _____

Drillers Remarks: red well bad

Yield in gpm: 12

Size pump: 3/4 H.P. Sub.

Type power: Electric

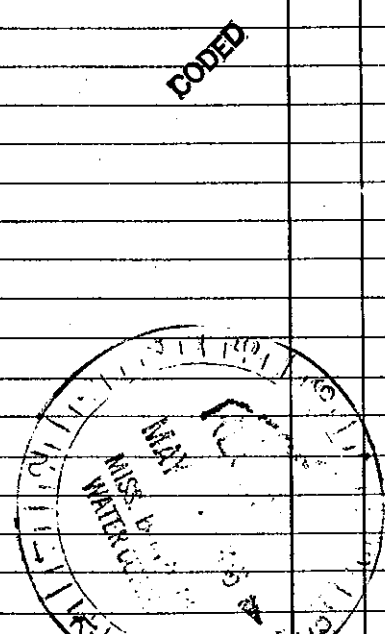

REEVES WELL & PUMP CO.
 P. O. BOX 71 - PHONE 384 (M8)
 McCOMB, MISS.

Mail this copy to Board of Water Commissioners 429 Miss. St. Jackson, Miss.