

FRANKLIN MISSISSIPPI BOARD OF WATER COMMISSIONERS


04

9-15-65 ^{CODED} WATER WELL DRILLERS LOG

Date: 9-15, 1965, Driller: J. T. Covington County Pike
 (Name)

(1) Owner of Land:	Description & Color of Materials Sand, Clay, Red Clay, Shell, etc.	Thick- ness Feet	Depth Feet
<u>Raymond Toney</u> (Name) <u>Meadville Miss</u> (Address)	<u>Sandy Chalk</u> <u>Chalk</u> <u>Sand</u>	<u>40</u> <u>160</u> <u>45</u>	<u>40</u> <u>200</u> <u>245</u>
(2) Location: <u>1/4</u> , <u>1/4</u> , Sec. <u>27</u> T <u>5</u> R <u>4</u> <u>21</u> miles <u>West</u> of <u>Summit</u> (distance) (direction) (Nearest Town)			
(3) Topography: <u>Hilly</u> (Hilly) (Flat) (Level)			
(4) Purpose of Well: <u>Domestic</u> (Domestic Irrigation Municipal, Industrial, Other)			
Information upon completion of well:			
(1) Diameter <u>4"</u> inches.			
(2) Total Depth <u>245'</u> feet.			
(3) Water Level <u>180'</u> feet below top of ground.			
(4) Cased to <u>245'</u> , Size <u>4"</u>			
(5) Screen: Size <u>4"</u> , Length <u>6'</u>			
(6) Were any formations sealed against pollution? <u>no</u>			
If YES depth of formation _____			
Why _____			
Drillers Remarks: _____			
			Well No.

CODED

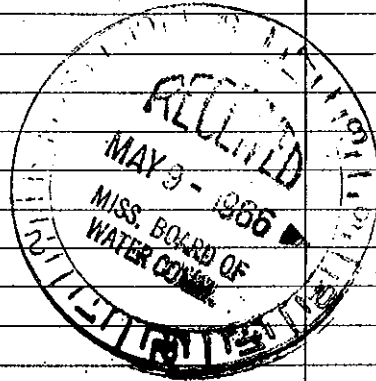

(Use Back Side)

Mail this copy to Board of Water Commissioners 429 Miss. St. Jackson. Miss.