

CODED

Franklin  
05  
2-67

MISSISSIPPI  
BOARD OF WATER COMMISSIONERS  
416 North State Street  
Jackson, Mississippi 39201

WATER WELL DRILLERS LOG

Feb 22 1967 REEVES WELL PUMP Franklin  
date well completed firm name county well located

HANDOWNER: Mt. Zion Baptist Church  
RFD 3, Meadville  
(mailing address)

description of formations encountered	from	to
Red clay	0	23
gray sand	23	47
Red sand	47	85
gray sand	85	90
yellow sand	90	119

WELL LOCATION:  
sec. 23 T. 5 N. R. 1 E  
6 3/4 miles of Bude  
(distance) (direction) (nearest town)

WELL PURPOSE: Home  
(home, irrigation, municipal, industrial)

WELL COMPLETION DATA:

(1) diameter (inches) 4"

(2) total depth (feet) 119

(3) static water level (feet) 92 <sup>below</sup> above top of ground.

(4) casing Plastic Bottom  
(material) (depth) 113

4 (size) if telescope see back.

(5) screen 6' 113'  
(length) (depth to top)

4" Plastic  
(size) (material)

(6) pump 1/2 HP 17  
(HP) (yield gpm)


Electric  
(type power)

(7) electric log No  
(yes or no)

(organization running log)

(8) how well bottom plugged

DRILLERS REMARKS:  
Well bad.

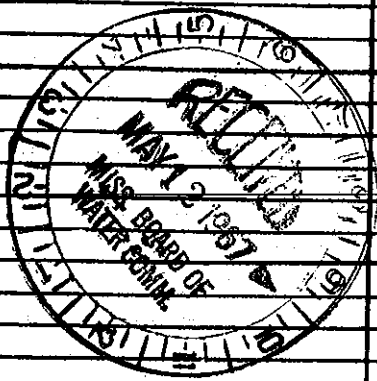

CODED