

Franklin
06
12-67

MISSISSIPPI BOARD OF WATER COMMISSIONERS

CODED

WATER WELL DRILLERS LOG

Date: Dec 13, 1967, Driller: J. T. Ewington County Franklin
(Name)

(1) Owner of Land: <u>OTIS Hester</u> (Name)	Description & Color of Materials Sand, Clay, Red Clay, Shell, etc.	Thick- ness Feet	Depth Feet
<u>Mendville, Miss.</u> (Address)	<u>2 1/2' Sand</u>	<u>0</u>	<u>35</u>
(2) Location: <u>NE 1/4, SW 1/4, Sec. 3 T5R14</u>	<u>ROCKS</u>	<u>35</u>	<u>60</u>
<u>7</u> miles <u>South E.</u> of <u>Mendville</u> (distance) (direction) (Nearest Town)	<u>SAND & ROCKS</u>	<u>60</u>	<u>90</u>
(3) Topography: <u>Hilly</u> (Hilly) (Flat) (Level)	<u>shell</u>	<u>90</u>	<u>160</u>
(4) Purpose of Well: <u>Domestic</u> (Domestic Irrigation Municipal, Industrial, Other)	<u>SAND & ROCKS</u>	<u>160</u>	<u>230</u>

Information upon completion of well:


- (1) Diameter 4 inches.
- (2) Total Depth 230' feet.
- (3) Water Level 160' feet below top of ground.
- (4) Cased to 230', Size 4"
- (5) Screen: Size 4", Length 6'
- (6) Were any formations sealed against pollution?
 yes, no.

If YES depth of formation _____

Why _____

Drillers Remarks: _____

Other logs will follow

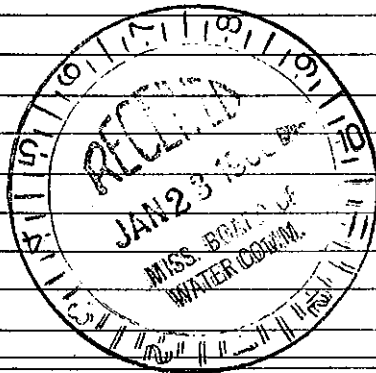

(Use Back Side)

Well No.