

FRANKLIN MISSISSIPPI BOARD OF WATER COMMISSIONERS

Φ 11  
10-28-65

CODED WATER WELL DRILLERS LOG

OK for 10/17/68

Date: 10-28, 1965, Driller: Chester Reeves County Franklin -  
(Name)

(1) Owner of Land	Description & Color of Materials Sand, Clay, Red Clay, Shell, etc.	Thick- ness Feet	Depth Feet
Troy Adams Rt 3 Meadville	clay Red sand gravel white chalk Red gravel Coarse sand	25 60 37 15	25 85 122 137
(2) Location: 1/4, 1/4, Sec. 3 T. 8 R. 4			
6 miles N of Meadville			
(3) Topography: Hilly			
(4) Purpose of Well: Domestic			

Information upon completion of well:

(1) Diameter 4 inches.

(2) Total Depth 138 feet.

(3) Water Level 107 feet below top of ground.

(4) Cased to Bottom, Size 4"

(5) Screen: Size 4", Length 6'


(6) Were any formations sealed against pollution?  
yes,  no.

If YES depth of formation \_\_\_\_\_

Why \_\_\_\_\_

Drillers Remarks: old well  
Bad

Description & Color of Materials Sand, Clay, Red Clay, Shell, etc.	Thick- ness Feet	Depth Feet
clay Red sand gravel white chalk Red gravel Coarse sand	25 60 37 15	25 85 122 137

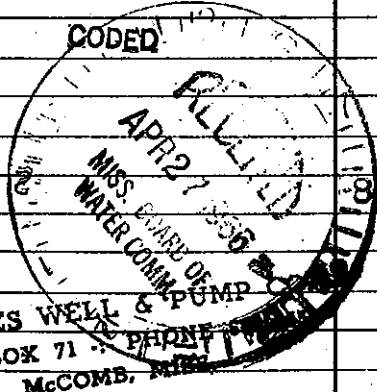

(Use Back Side)

Well No.

Mail this copy to Board of Water Commissioners 429 Miss. St. Jackson, Miss.