

FRANKLIN MISSISSIPPI BOARD OF WATER COMMISSIONERS

Ø13 CODED

4-9-65

WATER WELL DRILLERS LOG

OKGR  
10/17/68

Date: 4-9-65, Driller: Chester Reeves, County: Franklin

(1) Owner of Land: W.F. Jordan  
(Name)  
At-3 Meadville, Miss.  
(Address)  
14 5 4  
14 5 4  
Sec. 14 5 4  
(2) Location: 1/4, 1/4, Sec. 14 5 4  
8 miles East of Bude  
(distance) (direction) (Nearest Town)  
(3) Topography: Hilly  
(Hilly) (Flat) (Level)  
(4) Purpose of Well: Domestic  
(Domestic Irrigation  
Municipal, Industrial, Other)

Description & Color of Materials Sand, Clay, Red Clay, Shell, etc.	Thick- ness Feet	Depth Feet
Surface clay	2.5	2.5
Red sand & gravel	3.5	6.0
Hard pan	3.5	9.5
Coarse sand	8	103

Information upon completion of well:

(1) Diameter 4 inches.  
(2) Total Depth 103 feet.  
(3) Water Level 80 feet below top of ground.  
(4) Cased to Bottom Size 4"  
(5) Screen: Size 4", Length 7'  
(6) Were any formations sealed against pollution?  
yes,  no.

CODED


*Contract to be made*

If YES depth of formation

Why

Drillers Remarks: old well bad.

REEVES WELL & PUMP CO.  
P. O. BOX 71 -- PHONE 684-1451  
McCOMB, MISS.

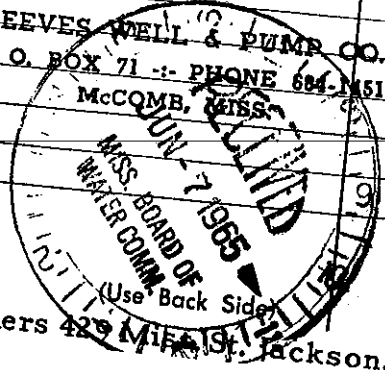

Well No.

File this copy to Board of Water Commissioners 429 Market St. Jackson, Miss.