

FRANKLIN

OK 94R
10/17/68

MISSISSIPPI BOARD OF WATER COMMISSIONERS

1-27-66

WATER WELL DRILLERS LOG

CODED

Date: 1-27, 1966, Driller: Chester Reems County Franklin
(When well drilled) (Name) (Where well is located)

(1) Owner of Land: Donald Halland
(Name)
RFD 3, Meadville.
(Address)

Description & Color of Material Sand, Clay, Red Clay, Shell, etc	Thick- ness Feet	Depth Feet
Clay gravel	25	25
Very fine sand	127	152
Coarse sand	10	162

(2) Location: 1/4, 1/4, Sec. 3 T5R4,
7 miles NE of Meadville.
(distance) (direction) (Nearest Town)


(3) Topography: Hilly -
(Hilly) (Flat) (Level)

(4) Purpose of Well: Domestic
(Domestic Irrigation
Municipal, Industrial, Other)

Information upon completion of well:

- (1) Diameter 4 inches.
- (2) Total Depth 162 feet.
- (3) Water Level 144 feet below top of ground.
- (4) Cased to bottom size 4
- (5) Screen: Size 4, Length 6'
- (6) Were any formations sealed against pollution?
yes, no.

CODED

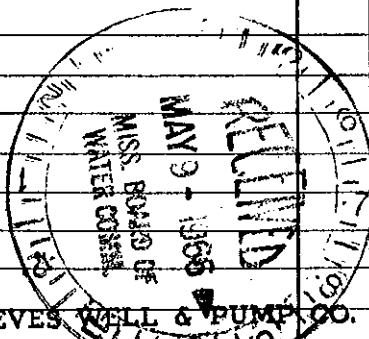

If YES depth of formation _____

Why _____

Drillers Remarks: red well bad

Yield in gpm: 10 gal -

Size pump: 3/4 HP Sub.

Type power: Electric

HEEVES WELL & PUMP CO.
P. O. BOX 711 BONEBRIDGE-1451
McCOMB, MISS.

Mail this copy to Board of Water Commissioners 429 Miss. St. Jackson, Miss.