

FRANKLIN MISSISSIPPI BOARD OF WATER COMMISSIONERS

~~Φ16~~
6-24-63

OK 1/17/68
QAC

CODED WATER WELL DRILLERS LOG

Date: 6-24, 1963, Driller: Chester Reeves County Franklin
(Name)

(1) Owner of Land:	Description & Color of Materials Sand, Clog, Red Clay, Shell, etc.	Thick- ness Feet	Depth Feet
G. L. Cathers (Name) RFD 3, Meadville (Address)	Red clay	20	20
	Sandy clay	30	50
	Sandy gravel	30	80
(2) Location: 1/4, 1/4, Sec. 26 N 5 R 4 7 miles East of Bude (distance) (direction) (Nearest Town)	Sandy gravel - Sand & gravel	17	97
		15	112
(3) Topography: Hilly (Hilly) (Flat) (Level)			
(4) Purpose of Well: Domestic (Domestic Irrigation Municipal, Industrial, Other)			


Information upon completion of well:

- (1) Diameter 4 inches.
- (2) Total Depth 112 feet.
- (3) Water Level 90 feet below top of ground.
- (4) Cased to bottom size 4
- (5) Screen: Size 4", Length 4"
- (6) Were any formations sealed against pollution?
yes, no.

If YES depth of formation _____

Why _____

Drillers Remarks: New House

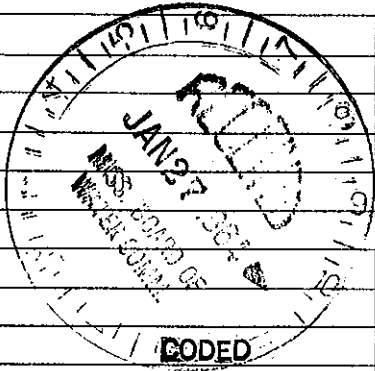

REEVES WELL & PUMP CO.
P. O. BOX 71 - PHONE 684-1451
McCOMB, MISS.

Well No.

(Use Back Side)

ail this copy to Board of Water Commissioners 429 Miss. St. Jackson, Miss