

FRANKLIN MISSISSIPPI BOARD OF WATER COMMISSIONERS

① 19
2-24-64

CODED

WATER WELL DRILLERS LOG CODED

Date: 2-24, 1964, Driller: Chester Reeves County: Franklin

(Name)

<p>(1) Owner of Land: <u>JAMES CATHEN</u> (Name) <u>RFD 1, Smithdale</u> (Address)</p>	<p>Description & Color of Materials Sand, Clay, Red Clay, Shell, etc.</p> <p>Red cherty clay Red sand Mixed gravel Brown gravel</p>	<p>Thick- ness Feet</p>	<p>Dep- th Feet</p>
<p>(2) Location: $\frac{1}{4}$, $\frac{1}{4}$, Sec. <u>26 T 5 R 4</u> <u>9</u> miles <u>west</u> of <u>Auburn</u> (distance) (direction) (Nearest Town)</p>	<p>60 60 30 90 35 125</p>		
<p>(3) Topography: <u>hilly</u> (Hilly) (Flat) (Level)</p>	<p>10 135</p>		
<p>(4) Purpose of Well: <u>Domestic</u> (Domestic Irrigation Municipal, Industrial, Other)</p>			

Information upon completion of well:

(1) Diameter 4 inches.

(2) Total Depth 135 feet.


(3) Water Level 118 feet below top of ground.

(4) Cased to bottom size 4"

(5) Screen: Size 4", Length 7'

(6) Were any formations sealed against pollution?
_____ yes, no.

CODED

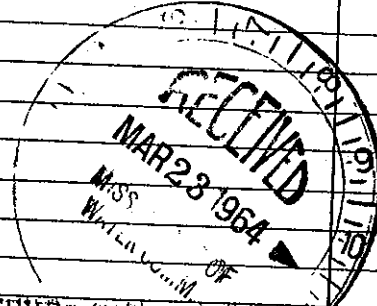

If YES depth of formation _____

Why _____

Drillers Remark: good well
bad

REEVES WELL & PUMP CO.
P. O. BOX 71 - PHONE 684-1451
RECOMB, MISS.

Well No.

(Use Back Side)

File this copy to Board of Water Commissioners 429 Miss. St. Jackson, Miss