

PI  
9-5-60

CODED


**WATER WELL DRILLERS LOG**

P 300

Date: 9-5, 1960, Driller: Warring Deming County Franklin  
Name

(1) Owner of Land: <u>Independence School</u> (Name)	Description & Color of Materials Sand, Clay, Red Clay, Shell, etc.	Thick- ness Feet	Depth Feet
<u>McCall Creek, Miss</u> (Address)	<u>Red Clay</u>	<u>15'</u>	<u>15'</u>
(2) Location: <u>N.E. 1/4, NW 1/4, Sec. 11 T. 5 R. 5</u>	<u>Clay</u>	<u>75'</u>	<u>90'</u>
<u>6</u> miles <u>S.E.</u> , of <u>McCall</u>	<u>Sand &amp; Gravel</u>	<u>4'</u>	<u>94'</u>
(distance) (direction) (Nearest Town)	<u>Clay</u>	<u>56'</u>	<u>150'</u>
(3) Topography: <input checked="" type="checkbox"/> (Level)	<u>Sand</u>	<u>25'</u>	<u>175'</u>
(4) Purpose of Well: <u>School</u> (Domestic Irrigation, Municipal, Industrial, Other)			
Information upon completion of well:			
(1) Diameter <u>2"</u> inches.			
(2) Total Depth <u>175'</u> feet.			
(3) Water Level <u>138'</u> feet below top of ground.			
(4) Cased to <u>170'</u> , Size <u>2"</u>			
(5) Screen: Size <u>2"</u> , Length <u>5'</u>			
(6) Were any formations sealed against pollution?			
_____ yes, _____ no.			
If YES depth of formation _____			
Why _____			
Drillers Remarks: _____			
_____			
_____			
_____			
_____			

CODED

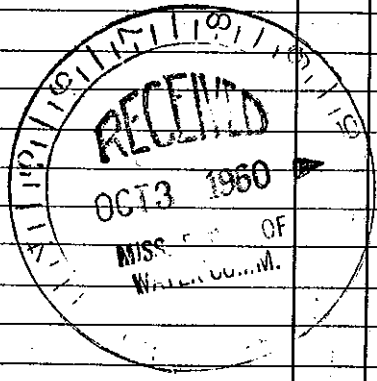

Well No.

(Use Back Side)

Mail this copy to Board of Water Commissioners 429 Miss. St. Jackson, Miss.