

CODED

MISSISSIPPI  
BOARD OF WATER COMMISSIONERS  
416 North State Street  
Jackson, Mississippi 39201

WATER WELL DRILLERS LOG

Franklin  
P3  
3-67

3-4-19 date well completed  
67 Fitzgerald Water Well Service firm name  
Franklin county well located

LANDOWNER: Jewell Pickett

description of formations encountered

from to

PH. MC Cell Branch

Miss.  
(mailing address)

Top Soil & Clay

0 18

Sand

15 35

White Chalk

40 95

Thin Sand

85 140

Sand & P gravel

30 170

WELL LOCATION:


sec. 9 T. 5 N. R. 5 E. S. W.  
9 miles 50 of McCell Branch  
(distance) (direction) (nearest town)

WELL PURPOSE: Home  
(home, irrigation, municipal, industrial)

WELL COMPLETION DATA:

- (1) diameter (inches) 4
- (2) total depth (feet) 170
- (3) static water level (feet) 100 below top of ground.
- (4) casing plastic, 162 (material), (depth)  
4 (size) If telescope see back.
- (5) screen 8, 162 (length), (depth to top)  
4 (size), plastic (material)
- (6) pump 3/4 (HP), 15 (yield gpm)  
Elec (type power)
- (7) electric log No (yes or no)

CODED

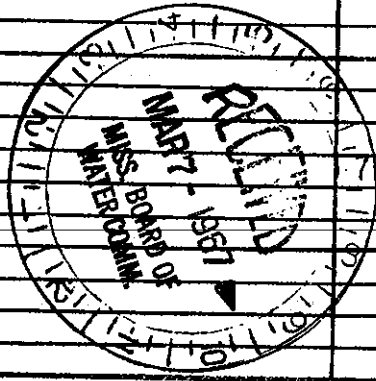

(organization running log)

(8) how well bottom plugged Wood peg

DRILLERS REMARKS: