

CODED

Franklin
PA
11-67

MISSISSIPPI
BOARD OF WATER COMMISSIONERS
416 North State Street
Jackson, Mississippi 39201

WATER WELL DRILLERS LOG

19 67 Fitzgerald Water Well Franklin
date well completed firm name county well located

LANDOWNER: Ottis Cotner
Smithdale Rd Miss.
(mailing address)


WELL LOCATION:
sec. 16 T. S N. R. 5 E.
1/4 miles (distance) W-NW of Summit (direction) (nearest town)

WELL PURPOSE: home
(home, irrigation, municipal, industrial)

- WELL COMPLETION DATA:
- (1) diameter (inches) 4
 - (2) total depth (feet) 153
 - (3) static water level (feet) 95 below top of ground.
 - (4) casing plastic 147
(material) (depth)
 - 4 If telescope see back.
(size)
 - (5) screen 6' 147
(length) (depth to top)
 - 4 plastic
(size) (material)
 - (6) pump — —
(HP) (yield gpm)
 - Elec
(type power)
 - (7) electric log no
(yes or no)
 - (organization running log)
 - (8) how well bottom plugged Wood peg

description of formations encountered	from	to
<u>Red gravel</u>	<u>0</u>	<u>22</u>
<u>Block</u>	<u>22</u>	<u>24</u>
<u>gravel</u>	<u>24</u>	<u>32</u>
<u>white shale</u>	<u>32</u>	<u>72</u>
<u>sand</u>	<u>72</u>	<u>84</u>
<u>white chert</u>	<u>84</u>	<u>108</u>
<u>fine sand</u>	<u>108</u>	<u>142</u>
<u>Coarse sand</u>	<u>142</u>	<u>153</u>
<u>chuck</u>	<u>153</u>	

CODED

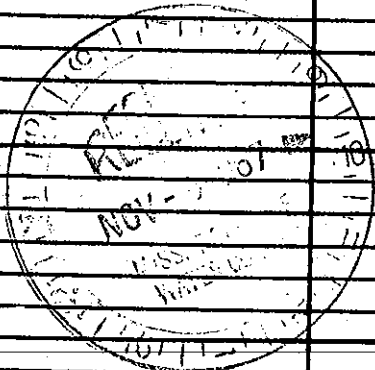

DRILLERS REMARKS: