

CODED

Franklin  
P5  
11-67

MISSISSIPPI  
BOARD OF WATER COMMISSIONERS  
416 North State Street  
Jackson, Mississippi 39201

WATER WELL DRILLERS LOG

11-28 1967 Fitzgerald Water Well Franklin  
date well completed firm name county well located

LANDOWNER Frank Allen  
Rt Smithdale

description of formations encountered	from	to
top soil & clay	0	26
Red sand	26	55
gravel	55	122
sand	122	137
gravel & sand	137	146

(mailing address)

WELL LOCATION:  
sec. 19 T. S N. 5 R. S E. 5  
10 miles SE of Meadville  
(distance) (direction) (nearest town)


WELL PURPOSE: home  
(home, irrigation, municipal, industrial)

WELL COMPLETION DATA:

- (1) diameter (inches) 4
- (2) total depth (feet) 146
- (3) static water level (feet) 100 below top of ground.
- (4) casing plastic 140'  
(material) (depth)  
4"  
(size) if telescope see back.
- (5) screen 6', 140'  
(length) (depth to top)  
4", plastic  
(size) (material)
- (6) pump Elec  
(HP) (yield gpm)  
(type power)
- (7) electric log no  
(yes or no)
- (8) how well bottom plugged Wood peg

Chalk →

CODED

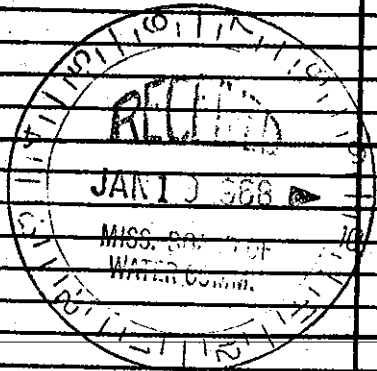

DRILLERS REMARKS: