

~~CODED~~  
P7  
9-16-65

MISSISSIPPI BOARD OF WATER COMMISSIONERS

OKger  
10/17/68  
Franklin

WATER WELL DRILLERS LOG

Date: 9-16, 1965, Driller: Chester Kewee County: Franklin

(1) Owner of Land	Description & Color of Materials Sand, Clay, Red Clay, Shell, etc.	Thick- ness Feet	Depth Feet
Reay Smith Rt-1, McCall Creek	Red Clay	12	12
15 miles west of Bonak	Coarse sand	67	79
Silty	Sand & small Red gravel	10	89
Purpose of Well: Domestic			

Information upon completion of well:

(1) Diameter 4 inches.

(2) Total Depth 59 feet.

(3) Water Level 60 feet below top of ground.


(4) Cased to bottom Size 4"

(5) Screen: Size 4", Length 7'

(6) Were any formations sealed against pollution?  
yes,  no.

Cannot locate

CODED

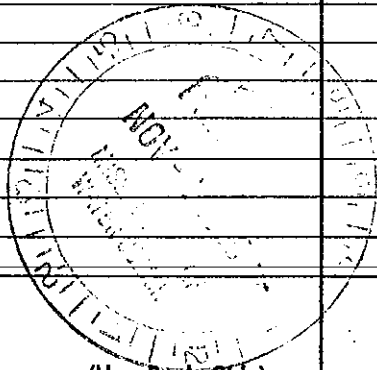

(Use Back Side)

Well No.

Mail this copy to Board of Water Commissioners 429 Miss. St. Jackson, Miss.