

Franklin
P 46
8-20-75

MISSISSIPPI
BOARD OF WATER COMMISSIONERS
416 North State Street
Jackson, Mississippi 39201

CODED

WATER WELL DRILLERS LOG

20 Aug 1975 J. T. Conington Franklin
date well completed firm name county well located

LANDOWNER:	description of formations encountered	from	to
H. Temple McCall Creek (mailing address)			

WELL LOCATION:
sec. 2 T. 5 N. R. 6 E. 14 P.
5 miles SE of McCall Creek
(distance) (direction) (nearest town)

WELL PURPOSE:
(home, irrigation, municipal, industrial)

WELL COMPLETION DATA:

(1) diameter (inches) 4

(2) total depth (feet) 74

(3) static water level (feet) 55 below above top of ground.

(4) casing 41 (material), 68 (depth)
(size) if telescope see back.

(5) screen 6 (length), 68 (depth to top)
4 (size), 41 (material)


(6) pump 1/2 (HP), 400 (yield gpm)
(type power)

(7) electric log (yes or no)

(organization running log)

(8) how well bottom plugged Wood

CODED

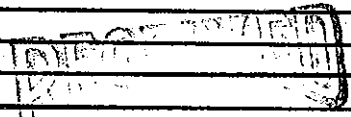

OCT - 6 1975

DRILLERS REMARKS:

MISS. BD. OF WATER