	State Well Kepult	T 05 V 01
County: FIAN KIN.	Part 1 - Driller's Log	For Office Use Only:
Permit #:	Mississippi Department of Environmental	
Driller: Fitzgerald Well Serge	Office of Land and Water Resources P.O. Box 10631	Well #:
	Jackson, MS 39289-0631	L. S. Elevation:
Date drilling completed: 937-05	(601)961-5210	
	(601)354-6938 (fax)	E-log #:
State Law requires that this repor	rt be prepared by the license holder respons	ible for the work and filed with the
Department at the above address	within 30 days of completion of drilling of	the well or borehole.
Information on Well ((Landowner if borehole is not for		ell or Borehole Location
0 01	Latitude: 31 º 2	3 <u>, 57 "</u> Longitude: 90 <u>, 44 , 02</u> "
Owner Name Chean MGhe		(circle one): Conventional Survey,
Mailing Address: Allen Rd	3	
	USGS quad, F	Hand-held GPS, Survey-grade GPS
C 111.	NW 1/4 SW 1/4 S	ec D Twn N Rng 5 F
	8	
City Sta	te Zip Code Distance Di	rection Nearesty Town
Telephone No. ()		
	Well / Borehole Data	
0.10 -		8/1
Date drilling started: 7775 Date dr	illing completed: 921-65. Hole depth:23	Hole diameter: 0
Location of the source of any surface water	er used for drilling:	
Method of dosing and volume of Chloring	e used in drilling and development:	
	Electric Gamma Ray Density Sonic N	
Purpose of borehole (check one): Water W	ell Geotechnical/Geological Investigation_	Ground Source Heat Pump
ruipose of borenoic (check one). Water W	ch deolecinical deological investigation	_ Ground Source Freat 1 unip
	Survey Other (describe) to water well construction, skip the remainder	of this block
Purpose of Well (check one): Home	ndustrial Public Supply Irrigation Fish	Culture Other:
If a flowing well, method of flow regulation	on: Valve Other (describe)	
	pove or below (circle one) land surface Date m	
Static Water Level:feet ab	bove or below (circle one) land surface Date m	leasured: / / / / /
Method of Measurement (circle one)	electric tape air line oth	er:
Well depth: <u>330</u> Well grouted to a de	epth of 10 feet Type of grout (circle one)	Neat Cement Bentonite Mix
Casing length: 220 feet Casin	ng diameter:inches Type of	casing:PVC
Screen length:feet Scre	en diameter:inches Type of s	screen: PVL
Screen slot size:inches	Setting depth: From 220 feet	tofeet
Type of completion (circle all applicable):	Gravel packed Underreamed Telescoped	Open hole Natural Development
	Other (describe):	
Top of lap pipe or reduction in casing:	feet. If telescoped or more than	one screen, describe on next page
7	era to sof the puna	Form: OLWR-SWR-
	A AR TO ACT TOU /Jeliai/1	

RECEIVED

OCT 19 2005

BY: OLWR


	The sketch	below on	ily required	for water	r wells
--	------------	----------	--------------	-----------	---------

If well telescopes,	show	depths	on	sketch.
Ground Level.		_		

<u>Description of formations encountered must be provided for all wells and boreholes, unless specifically exempted by regulations</u>

Description of Formations Encountered	From (depth)	To (depth)
	Ground Level	
Cluy.	0	20
Sandy	20	(90)
ywe!	60	80
Jeluyi	80	100
Clay	100	120
Scurd,	120	122
cluy.	izz	190
Fire share	190	220
Eve Shind Course Sound + small Sicuel	230	230
srae!		
9		

If more than one screen, show location of each on sketch

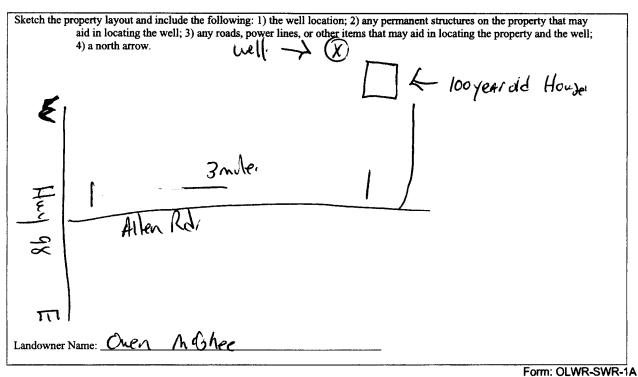

I certify that the well/borehole was drilled, constructed, and completed in accordance with all applicable requirements of the Mississippi Department of Environmental Quality and the Mississippi Department of Health regulations, if applicable, and state

Brad Etzgevald

Print Name of Responsible Licensee and License No.

079

9-27-05.

Signature of Licens

RECEIVED

OCT 19 2005

BY: OLWR