State V	Vell Report	
	Point 1 Durillouria Log	
Mississippi Departme	Mississippi Department of Environmental Quality Office of Land and Water Resources	
P.O.	Box 2309 Well #:	
	n, MS 39225 961- 5210 L. S. Elevation:	
	i1- 5228 (fax) E-log #:	
State Law requires that this report be prepared by the lid		
Department at the above address within 30 days of com	pletion of drilling of the well or borehole.	
Information on Well Owner	Well or Borehole Location	
(Landowner if borehole is not for a water well)	Latitude: 31 ° 23, 38.5 Longitude 90° 41, 19.5	
Owner Name Fay 6 Orden	Method of Lat/Long (circle one): Conventional Survey,	
Mailing Address: Cowart RJ.	USGS quad, Hand-held GPS, Survey-grade GPS	
	SW, SE 1 Sec S Twn SN Kng SE	
<u>Mull Creet.</u> City State Zip Code	7 - , JL 74 Sec J Iwn J IV Rng J L	
City State Zip Code	Distance Direction Nearest Town Miles of	
Telephone No. ()		
Well / Borehole Data		
Date drilling started: $23-12$. Date drilling completed: $7-3-12$. Hole depth: 200^{-1} Hole diameter: 8^{11}		
Location of the source of any surface water used for drilling: Method of dosing and volume of Chlorine used in drilling and deve	clopment:	
Logs run (circle all applicable): Notog ram Electric Gamma Ray Name of organization running log(s):	y Density Sonic Neutron Other:	
Purpose of borehole (check one): Water Well Ceotechnical/Geo	logical Investigation Ground Source Heat Pump	
Seismic SurveyOther (<i>describe</i>)		
If drilling is not related to water well construction, skip the remainder of this block		
Purpose of Well (check one): HomeIndustrial Public Supply Irrigation Fish Culture Other:		
If a flowing well, method of flow regulation: Valve Other (describe)		
Static Water Level: <u>140</u> feet above or below (circle one) land surface Date measured: <u>7-3-12</u> ,		
Method of Measurement (circle one) steel tape electric tap	e air line other:	
Well depth: 200' Well grouted to a depth of 10' feet Type of grout (circle one): Keat Cement Bentonite Mix		
Casing length: <u>190</u> feet Casing diameter: <u>911</u> inches Type of casing: <u>μ_{ℓ}</u>		
Screen length: <u>10</u> feet Screen diameter: <u>9"</u>		
Screen slot size: <u></u>	190 feet to 200 feet	
Type of completion (circle all applicable): Gravel packed Under	erreamed Telescoped Open hole Natural Development	
Other (describe):		
Top of lap pipe or reduction in casing:feet. If i	elescoped or more than one screen. describe on next page	
L	Form: OLWR-SWR-1A (04/08)	

•

RECEIVED AUG 0 6 2012 BY: OLWR

P117


The sketch below only required for water wells

If well telescopes, show depths on sketch. Ground Level_____

	Description of Formations Encountered	From (depth)	To (depth)
		Ground Level	
	Clay.	0	20
	Greevel.	20	40
	cluy-	40	80
	Cluy-	80	120
	Sand	120	140
	Cluy-	140	180
	6 culding	180	190
	(oule sand	190	200
•			
			1
		1	
			<u> </u>
		+	<u>+</u>
		+	<u> </u>
		L	ļ

<u>Description of formations encountered must be provided for all</u> wells and boreholes, unless specifically exempted by regulations

If more than one screen, show location of each on sketch

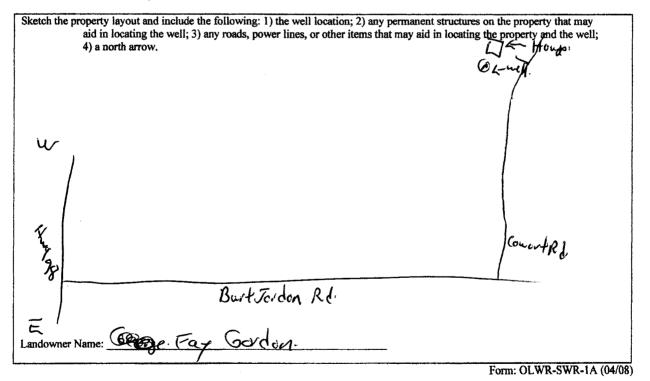

I certify that the well/borehole was drilled, constructed, and completed in accordance with all applicable requirements of the Mississippi Department of Environmental Quality and the Mississippi Department of Health regulations, if applicable, and state

laws. BIAd Filzgerald

029. 7-3-12-Date

DECENED AUG 0 6 2012

Print Name of Responsible Licensee and License No.

<u>|StelfMyW</u> Signature of Licensee

3Y: OLWR

P118

County: <u>F/An.Fl.n</u> Permit #: Driller: <u>F(+z)e/al (uell Serze</u> , Mississippi Departmen Office of Land P.O. Jackson (601	ELL REPORT For Office Use Only: Part 2 Aquifer: 's Completion Report
This part of the report must be completed by a licensed water well	contractor or a licensed pump installer. A copy of Part 1 of the
report must be attached and both parts filed with the Department of Well Owner Information	at the above address within 30 days of well completion. Well Location
Owner Name: Care - Fay Gor don.	Latitude: 31°23'385 Longitude: 10°41' 195"
Mailing Address: Cowart Rd	Method of Lat/Long (check one): Conventional Survey,
Mailing Address: COWART NO	
ad il c. le	USGS quad, Hand-held GPS, Survey-grade GPS ¼ ¼ Sec T_ <u>5N</u> R_5 <u>F</u>
<u> Mull (reeb</u> City State Zip Code	¼¼ Sec_/T <u>_7//R</u> 6
Telephone No. ()	Distance Direction Nearest TownMilesof
Ритр Туре	Power Type
Circle one Air Lift Jet Submersible	Circle one Diesel Engine Gasoline Engine Natural Gas
Bucket Piston Turbine	Recenter Motor, Hand Tractor PTO
Centrifugal Rotary Flowing Well	Windmill Other (specify):
	Horse Power Rating of Motor:
Other (specify): Date Pump Installed:7-3-/2	Setting Depth:feet
	Number of Stages:
Rated Pump Capacity: Gallons Per Minute	Number of Stages:
Pump Test Data	Method of Measuring Water Level
Date Well Tested:	Circle one Air Line Electric Measuring Line Steel Tape
Static Water Level (A):Feet Below Land Surface	Other (specify):
Pumping Water Level (B):Feet Below Land Surface	Oner (specify).
Drawdown [(B) – (A)]:Feet Below Land Surface	For flowing well, measured shut in head:feet
Test Pumping Rate:Gallons Per Minute	Well yielded GPM with a drawdown of
Duration of Pump Test (minimum 4 hours):hours	hours of pumping
Duranon of Lump Loss (minimum + 2003).	
	Duration of Breisting Dump
This is for (circle one): New Well Replacement of E	xisting Pump Repair of Existing Pump
I HEREBY CERTIFY that the above statements are true to the bes	t of my knowledge.
Bradfilzerald. 029.	(Sal JUM)
Print Name of Pump Installer and License No. (if applicable)	Signature of Pump Installer Form: OLWR-SWR
	AUG 0 6
	BA: O

۰. «

•