

# STATE WELL REPORT

## Part 1

### Driller's Log

Mississippi Department of Environmental Quality  
Office of Land and Water Resources  
P.O. Box 2309  
Jackson, MS 39225-2309  
(601)961-5210  
(601)360-0535 (fax)

#### For Office Use Only:

Well #: P133  
Aquifer: \_\_\_\_\_  
E-Log #: \_\_\_\_\_

County: Franklin  
Permit #: \_\_\_\_\_  
Driller: GREEN WATER WELL & SUPPLY, INC.  
Date drilling completed: 9-18-14

*State Law requires that this report be prepared by the license holder responsible for the work and filed with the Department at the above address within 30 days of completion of drilling of the well or borehole.*

<p style="text-align: center;"><b>Well Owner Information</b> (Landowner if borehole is not for a water well)</p> <p>Owner Name: <u>JEFF McEWEN</u></p> <p>Mailing Address: <u>5908 Allen Rd</u></p> <p><u>McCall Creek MS 39647</u> City State Zip Code</p> <p>Telephone No. <u>(601) 757-6517</u></p>	<p style="text-align: center;">Well or Borehole Location <u>31° 24' 58" N 90° 41' 34" W</u></p> <p>Latitude: <u>31° 24.836</u> Longitude: <u>90° 41.578</u></p> <p>Method of Lat/Long (check one): Conventional Survey _____, Hand-held GPS <input checked="" type="checkbox"/>, Survey-grade GPS _____</p> <p>USGS quad _____, Sec <u>10</u> T. <u>5N</u> R. <u>5E</u></p> <p><u>6</u> Miles <u>S</u> of <u>McCall Creek</u> (Distance) (Direction) (Nearest Town)</p>
--	---


<b>Well / Borehole Data</b>
Date drilling started: <u>9-18-14</u> Date drilling completed: <u>9-18-14</u> Hole depth: <u>108</u> Hole diameter: <u>7</u>
Location of the source of any surface water used for drilling: _____
Method of dosing and volume of Chlorine used in drilling and development: <u>Mud pit - gravel pack</u>
Logs run (circle all applicable): <input checked="" type="checkbox"/> No log run <input type="checkbox"/> Electric <input type="checkbox"/> Gamma Ray <input type="checkbox"/> Density <input type="checkbox"/> Sonic <input type="checkbox"/> Neutron Other: _____
Name of organization running log(s): _____
Purpose of borehole (circle one): <input checked="" type="radio"/> Water Well <input type="radio"/> Geotechnical/Geological Investigation <input type="radio"/> Ground Source Heat Pump <input type="radio"/> Seismic Survey <input type="radio"/> Other (describe) _____
<i>If drilling is not related to water well construction, skip the remainder of this block</i>
Purpose of Well (circle all applicable): <input checked="" type="radio"/> Home <input type="radio"/> Industrial <input type="radio"/> Public Supply <input type="radio"/> Irrigation <input type="radio"/> Fish Culture
Other (describe): _____
If a flowing well, method of flow regulation: Valve _____ Other (describe) _____
Static Water Level: <u>84</u> feet (above or <input checked="" type="checkbox"/> below) land surface Date measured: <u>9-18-14</u> (circle one)
Method of measurement (circle one): Steel tape <input checked="" type="checkbox"/> Electric tape <input type="checkbox"/> Air line Other (describe) _____
Well depth: <u>102</u> Well grouted to a depth of: <u>10</u> feet Type of grout (circle one): Neat Cement <input checked="" type="checkbox"/> Bentonite <input type="checkbox"/> Mix
Casing length: <u>92</u> feet Casing diameter: <u>4</u> inches Type of casing: <u>PVC</u>
Screen length: <u>10</u> feet Screen diameter: <u>4</u> inches Type of screen: <u>PVC</u>
Screen slot size: <u>.010</u> inches Setting depth: From <u>92</u> feet to <u>102</u> feet
Type of completion (circle all applicable): <input checked="" type="checkbox"/> Gravel packed <input type="checkbox"/> Underreamed <input type="checkbox"/> Open hole <input type="checkbox"/> Natural Development
Other (describe): _____
Top of tap pipe or reduction in casing: _____ feet
<i>If telescoped or more than one screen, describe on next page</i>

County: Franklin  
 Permit #: \_\_\_\_\_

**For Office Use Only:**  
 Well #: \_\_\_\_\_

The sketch below only required for water wells


If well telescopes, show depths on sketch.

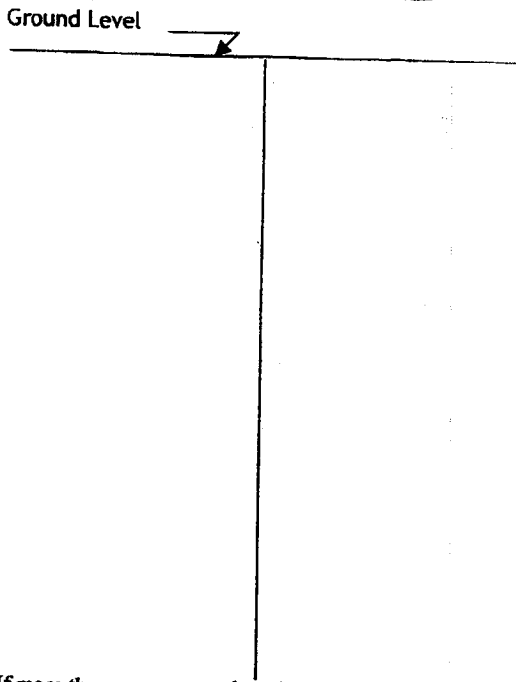

Description of formations encountered must be provided for all wells and boreholes, unless specifically exempted by regulations

Description of Formations Encountered	From (depth)	To (depth)
red clay	Ground level	15
sand	15	27
gravel	27	105
yellow clay	105	108

If more than one screen, show location of each on sketch

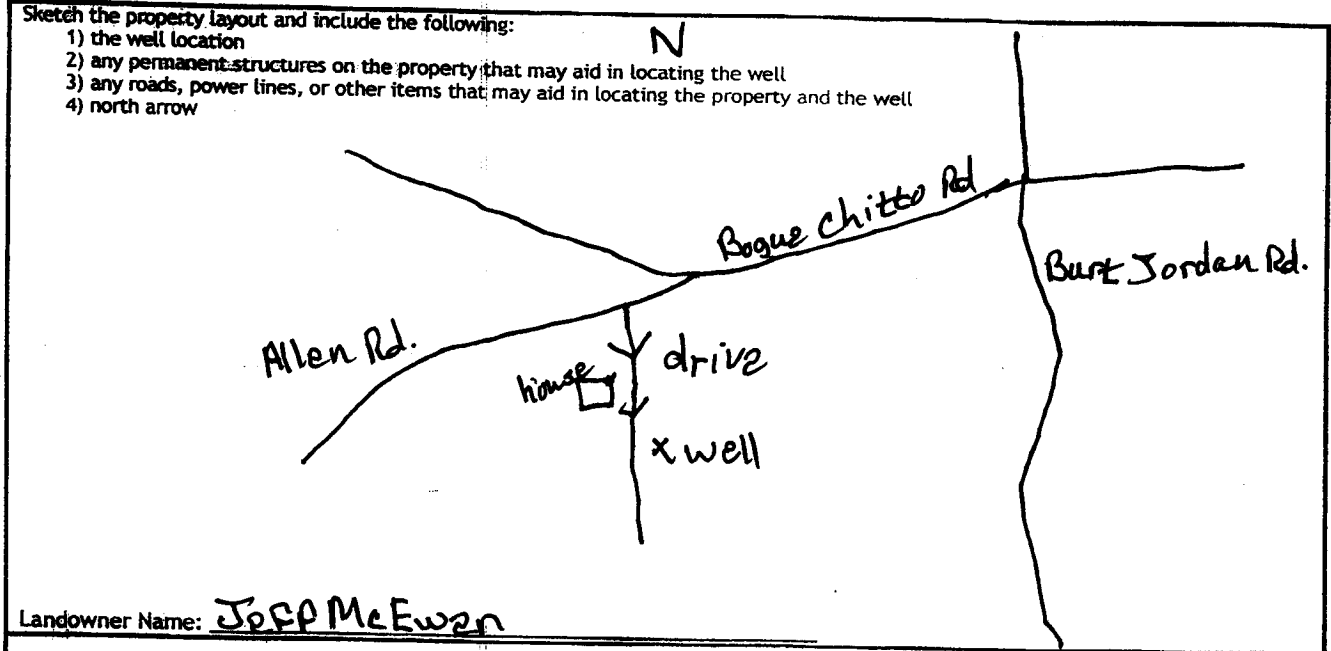

Landowner Name: Jeff McEwan

I HEREBY CERTIFY that the well/borehole was drilled, constructed, and completed in accordance with all applicable requirements of the Mississippi Department of Environmental Quality and the Mississippi Department of Health regulations, if applicable, and state laws.

BRIAN D. MCCLENDON UNR-00000664  
 Print Name of Responsible Licensee and License No.

9-18-14  
 Date

Brian McClendon  
 Signature of Licensee

# STATE WELL REPORT

## Part 2

**Pump Installer's Completion Report**  
 Mississippi Department of Environmental Quality  
 Office of Land and Water Resources  
 P.O. Box 2309  
 Jackson, MS 39225-2309  
 (601)961-5210  
 (601) 360-0535 (fax)

County: Franklin  
 Permit #: \_\_\_\_\_  
 Driller: GRENN WATER WELL & SUPPLY, INC.  
 Date completed: 9-19-14  
Copy information from block on Part 1

**For Office Use Only:**

Well #: 8133  
 Aquifer: \_\_\_\_\_

*This part of the report must be completed by a licensed water well contractor or a licensed pump installer. A copy of Part 1 of the report must be attached and both parts filed with the Department at the above address within 30 days of well completion.*

<b>Well Owner Information</b>		<b>Well Location</b>	
Owner Name: <u>Jeff McEwen</u>	Latitude: <u>31° 24' 50"</u>	Longitude: <u>90° 41' 34"</u>	
Mailing Address: <u>5908 Allen Rd</u>	Method of Lat/Long (check one): Conventional Survey _____, USGS quad _____, Hand-held GPS <input checked="" type="checkbox"/> , Survey-grade GPS _____		
<u>McCall Creek MS 39647</u>	<u>NE 1/4 NW 1/4, Sec 10 T 5N R 8SE</u>		
City State Zip Code	<u>6</u> Miles <u>S</u> of <u>McCall Creek</u>		
Telephone No. <u>(601) 757-6517</u>	(Distance) (Direction) (Nearest Town)		

**Pump Type (circle one)**

Submersible Turbine Air Lift Centrifugal Flowing Well Jet Piston Rotary Other (describe): \_\_\_\_\_

Date Pump Installed: 9-19-14 Rated Pump Capacity: 10 Gallons Per Minute

Is This Pump (circle one):  New  Repaired  Replacement

**Power Type (circle one)**

Electric Diesel Gasoline Natural Gas Tractor PTO Windmill Other (describe): \_\_\_\_\_

Horse Power Rating of Motor: 3/4 Setting Depth: 101 feet Number of Stages: 9

**Pump Test Data for Non Flowing Well**

Date Well Tested: 9-19-14 Duration of Pump Test (minimum 4 hours): 4 hours

Static Water Level (A): 84 Feet Below Land Surface Pumping Water Level (B): 87 Feet Below Land Surface

Drawdown [(B) - (A)]: 3 Feet Below Land Surface Test Pumping Rate: 10 Gallons Per Minute

Method of measurement (circle one): Steel tape  Electric tape Air line Other (describe): \_\_\_\_\_

**Pump Test Data for Flowing Well**

Measured shut in head: \_\_\_\_\_ feet.

Well yielded \_\_\_\_\_ GPM with a drawdown of \_\_\_\_\_ feet after \_\_\_\_\_ hours of pumping

**Meter Installation**

Meter Manufacturer: \_\_\_\_\_ Meter Serial Number: \_\_\_\_\_

Meter Model Number/Name: \_\_\_\_\_ Type of Meter: \_\_\_\_\_

Totalizer Register Unit and Multiplier Factor (AF x .001, gal x 1000, etc): \_\_\_\_\_

Installation Date: \_\_\_\_\_ Meter installed by: \_\_\_\_\_

Is This Meter (circle one):  New  Repaired  Replacement

*Important: By submitting the above information you are certifying that this meter was installed to manufacturer standards. For agricultural wells, a list of approved meters is on the MDEQ website.*

I HEREBY CERTIFY that the above statements are true to the best of my knowledge.

MICHAEL W. KEES RPO-00000801 9-19-14 Michael K  
 Print Name of Pump Installer and License No. (if applicable) Date Signature of Pump Installer