


**FRANKLIN**  
 P 2002  
 3-22-76

**MISSISSIPPI  
 BOARD OF WATER COMMISSIONERS**  
 416 North State Street  
 Jackson, Mississippi 39201

**WATER WELL DRILLERS LOG**

3-22-76 date well completed  
 76 Fitzgerald & Son firm name  
 Franklin county well located

LANDOWNER:	description of formations encountered	from	to
Jack Bevis			
P.R. Meadeville, Jr. (mailing address)	red clay white chert course sandstone	0 20 90	20 90 112
<b>WELL LOCATION:</b>			
sec. 28 T 6 N R 5 E			
10 miles NW of Auburn			
(distance) (direction) (nearest town)			
<b>WELL PURPOSE:</b> (home, irrigation, municipal, industrial)			
<b>WELL COMPLETION DATA:</b>			
(1) diameter (inches) 4			
(2) total depth (feet) 112			
(3) static water level (feet) 35 below top of ground.			
(4) casing PVC, 104' (material) (depth)			
4 (size) if telescope see back.			
(5) screen 8, 104' (length) (depth to top)			
4, PVC (size) (material)			
(6) pump 1/2, 10 (HP) (yield gpm)			
ele. (type power)			
(7) electric log (yes or no)			
(organization running log)			
(8) how well bottom plugged			
Sullink			
<b>DRILLERS REMARKS:</b>			

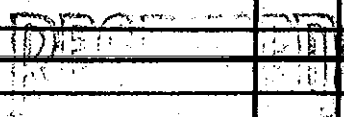

APR - 7 1976