

MISSISSIPPI DEPARTMENT OF ENVIRONMENTAL QUALITY

Office of Land and Water Resources

COUNTY WELL LOCATED <u>Franklin</u>	
WELL NUMBER <u>P 2067</u>	CODED
DATE WELL COMPLETED <u>4-26-96</u>	

PERMIT NUMBER <u>Gretn Water Well & Supply</u>
NAME OF DRILLER <u>1318 Priessdale Dr. SE Bogue Chitto, MS 39629</u>

P. O. Box 10631
Jackson, MS 39289-0631
WATER WELL DRILLERS LOG

NAME & MAILING ADDRESS OF LANDOWNER <u>J. D. Patchiff</u>			
<u>229 Camelia</u>			
<u>La Place LA</u>			
WELL LOCATION	SEC	TOWNSHIP	RANGE
	<u>18</u>	<u>5</u> ^N _S	<u>6</u> ^E _W
DISTANCE	DIRECTION	NEAREST TOWN	
<u>9</u> Miles	<u>S</u>	of <u>Lucia</u>	
OTHER LANDMARK			
WELL PURPOSE <input checked="" type="checkbox"/> Home, <input type="checkbox"/> Irrigation, <input type="checkbox"/> Municipal, <input type="checkbox"/> Industrial, <input type="checkbox"/> Fish Pond, etc.			

PUMP DATA		
PUMP TYPE (Circle One): <input checked="" type="checkbox"/> Submersible, <input type="checkbox"/> Turbine, <input type="checkbox"/> Jet <input type="checkbox"/> Flowing Well, Other (Describe) _____		
POWER TYPE (Circle One): <input checked="" type="checkbox"/> Electric, <input type="checkbox"/> Tractor, <input type="checkbox"/> Diesel, <input type="checkbox"/> Gasoline, <input type="checkbox"/> Butane, Other (Describe) _____ H/P <u>1/2</u>		
Pump Capacity (GPM) <u>10</u>	No. of Stages <u>9</u>	Setting Depth <u>107</u> FT.
PUMP TEST		
Well yielded <u>10</u> GPM with a drawdown of <u>10</u> ft. after <u>1</u> hours of pumping		

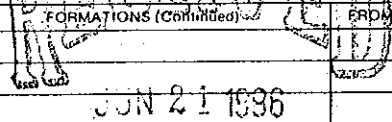
WELL DATA		
Well Depth <u>110</u>	Casing Diameter (In.) <u>4</u>	Casing Length (Ft.) <u>100</u>
Type of Casing <u>PVC</u>	Hole Depth <u>120</u>	Depth to Static Water Level <u>80</u>
TYPE OF COMPLETION: (Circle One or More): <input checked="" type="checkbox"/> Gravel Packed, <input type="checkbox"/> Underreamed, <input type="checkbox"/> Telescoped, <input type="checkbox"/> Natural Development, <input type="checkbox"/> Open Hole, <input type="checkbox"/> Other		
WELL GROUTED TO A DEPTH OF <u>10</u> FEET Type Grout (circle one): Cement, Bentonite, or <u>MIX</u>		

LOG DATA	
TYPE OF LOG RUN (Circle One): Electric, Gamma-Ray, Density, Sonic, <input checked="" type="checkbox"/> No Log Run, Other (Describe) _____	
Name of Organization Running Log	

SCREEN DATA		
Diameter - Inches <u>4</u>	Length - Feet <u>10</u>	Slot Size - Inches <u>.010</u>
Screen Type <u>PVC</u>	Depth to Bottom - Feet <u>110</u>	

GEOLOGIC DATA (Office Use Only)			
Surface Elev.	Geologic Unit	Unit Thickness	Depth to Top
Subs SWL	Date	Analysis	Aquifer Test

Driller's Remarks	
Top of Lap Pipe or Reduction in Casing	
<u>10</u> FEET IF TELESCOPED OR MORE THAN ONE SCREEN USE BACK PAGE	

DESCRIPTION OF FORMATIONS ENCOUNTERED	FROM	TO	FORMATIONS (Continued)	FROM	TO
Red Clay	0	25			
Sand & Gravel	25	117			
Yellow Clay	117	120			
Dept. of Environmental Quality Office of Land & Water Resources					
IF MORE SPACE IS NEEDED, USE BACK					