

~~MISSISSIPPI~~ MISSISSIPPI BOARD OF WATER COMMISSIONERS

GEORGE

A 7000


9-10-60

WATER WELL DRILLERS LOG

Date: 9-10, 1960, Driller: Hermon Parker County: [Redacted]
 (Name)

(1) Owner of Land: W. L. Fore
 (Name)
Leak, Miss
 (Address)
 (2) Location: 1/4, 1/4, Sec. 2 T1 R8
20 miles West of Lucedale
 (distance) (direction) (Nearest Town)
 (3) Topography: Flat
 (Hilly) (Flat) (Level)
 (4) Purpose of Well: Domestic
 (Domestic Irrigation, Municipal, Industrial, Other)

Description & Color of Materials Sand, Clay, Red Clay, Shell, etc.	Thick- ness Feet	Depth Feet
<u>Sand (Red)</u>		<u>10</u>
<u>Red Clay</u>		<u>30</u>
<u>Red Sand</u>		<u>35</u>
<u>Well</u>		<u>75</u>

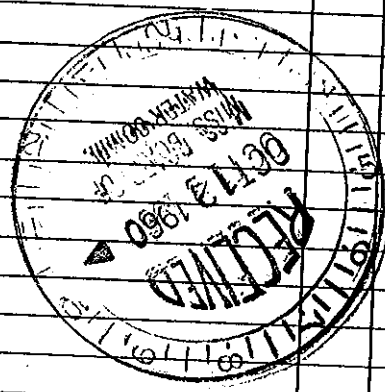

Conrad Smith
RA

Information upon completion of well:

(1) Diameter 2" inches.
 (2) Total Depth 85 feet.
 (3) Water Level 30 feet below top of ground.
 (4) Cased to 75, Size 2"
 (5) Screen: Size 2", Length 5'
 (6) Were any formations sealed against pollution?
 _____ yes, no.

If YES depth of formation _____

Why _____

Drillers Remarks: _____

Well No. 2

(Use Back Side)

Mail this copy to Board of Water Commissioners 429 Miss. St. Jackson, Miss.