

GROUNDWATER WELL DRILLERS LOG


A 7001

Date: 9-10-60, 1960, Driller: Herman Parker County: [scribble]

9-10-60

(Name)

(1) Owner of Land: <u>W. L. Fore</u> (Name)	Description & Color of Materials Sand, Clay, Red Clay, Shell, etc.	Thick- ness Feet	Depth Feet
<u>Lesq, Miss.</u> (Address)	7 <u>Sand</u>	<u>10</u>	<u>10</u>
(2) Location: <u>NE 1/4, SW 1/4, Sec. 2</u> ¹⁵ ₈₀₀ T <u>R</u>	<u>Red clay</u>		<u>30</u>
<u>20</u> miles <u>West</u> , of <u>Lucedale</u> (distance) (direction) (Nearest Town)	<u>Red sand</u>		<u>40</u>
(3) Topography: <u>Flat</u> (Hilly) (Flat) (Level)	<u>Well</u>		<u>80</u>
(4) Purpose of Well: <u>Domestic</u> (Domestic Irrigation Municipal, Industrial, Other)			

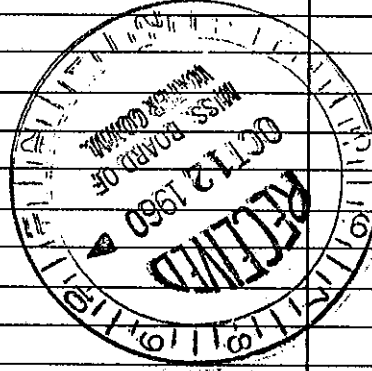

Information upon completion of well:

(1) Diameter 2 inches.

(2) Total Depth 80 feet.

(3) Water Level 30 feet below top of ground.

(4) Cased to 75, Size 2"

(5) Screen: Size 2" , Length 5'

(6) Were any formations sealed against pollution?
 yes, no.

If YES depth of formation _____

Why _____

Drillers Remarks: _____

*Cannot locate
RT*

Well No. 1

(Use Back Side)

Mail this copy to Board of Water Commissioners 429 Miss. St. Jackson, Miss.