

George
B16
3-67

MISSISSIPPI
BOARD OF WATER COMMISSIONERS
416 North State Street
Jackson, Mississippi 39201

WATER WELL DRILLERS LOG

March 31 1967 M&B Drilling Co. George
date well completed firm name county well located

LANDOWNER: Mrs. Cooley
R.R.
Lucedale, Miss.
(mailing address)

WELL LOCATION:
sec. 5 T. 1 N. R. 7 E.
1 1/2 miles E of Merriall
(distance) (direction) (nearest town)

WELL PURPOSE: Home & Farm
(home, irrigation, municipal, industrial)

WELL COMPLETION DATA:

- (1) diameter (inches) 2"
- (2) total depth (feet) 397
- (3) static water level (feet) 50 below above top of ground.
- (4) casing PVC Plastic 388 (material) (depth)
- (size) if telescope see back.
- (5) screen 9 FT 388 (length) (depth to top)
- 2" Sand Filter Bag with (size) (material) PVC
- (6) pump None (HP) (yield gpm)
- (type power)


(7) electric log No (yes or no)

(organization running log)

(8) how well bottom plugged 2" Plastic Cap

| description of formations encountered | from to | |
|---------------------------------------|---------|-----|
| | | |
| Surface Sand & Silt | 0 | 20 |
| Sand Gravel & Gray Clay | 0 | 73 |
| Light Gray Clay | 73 | 110 |
| White Sand | 110 | 125 |
| Blue Clay | 125 | 170 |
| Gray Sand | 170 | 184 |
| Blue Clay | 184 | 235 |
| Old Swamp Black Muck | | |
| Bank, Sand, etc. | 235 | 260 |
| Blue Clay | 260 | 300 |
| Sandy Clay & Gravel | 300 | 350 |
| Medium Sand | 350 | 398 |

Stopped Drilling & still in Sand.

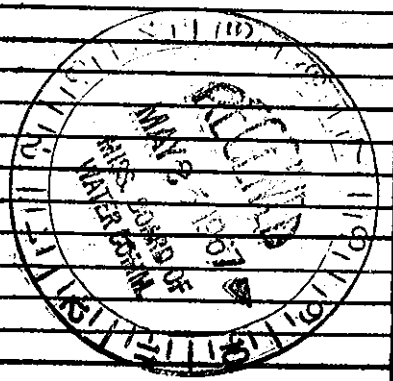

DRILLERS REMARKS: