

County: Levy
 Permit #: _____
 Driller: Mike + Wood
 Date drilling completed: 10-5-07

Well Driller Report and Well Log
 Mississippi Department of Environmental Quality
 Office of Land and Water Resources
 P.O. Box 10631
 Jackson, MS 39289-0631
 (601)961-5210
 (601)354-6938 (fax)

For Office Use Only:

Aquifer: _____
 Well #: B-82
 L. S. Elevation: _____
 E-log #: _____

State Law requires that this report be prepared by the driller in detail and filed with the Department within 30 days of completion of drilling of the well.

Well Owner Information	Well Location
Owner Name: <u>David Wilson</u>	Latitude: <u>30° 55' 28" N</u> Longitude: <u>88° 38' 28" W</u>
Mailing Address: <u>118 Robin Ln</u>	Method of Lat/Long (circle one): <u>Conventional Survey</u>
<u>Lucedal MS 39452</u>	USGS quad, <u>Hand-held GPS</u> , Survey-grade GPS
City State Zip Code	<u>NW 1/4 NE 1/4 Sec 36 Twn 15 Rng R7W</u>
Telephone No. () _____	Distance Direction Nearest Town <u>2 Miles W of Lucedal</u>

Well Data

Purpose of Well (circle one) Home Industrial Public Supply Irrigation Fish Culture Other: _____

Date well drilling started: 10-5-07 Date well drilling completed: 10-5-07

If flowing, method of flow regulation: Valve _____ Other (describe) _____

Static Water Level: 50 feet above or below (circle one) land surface Date measured: _____

Method of Measurement (circle one) steel tape electric tape air line other: _____

Hole depth: 72 Well depth: 72 Well grouted to a depth of 10 feet

Type of grout (circle one): Cement Bentonite Mix

Casing length: 67 feet Casing diameter: 2 inches Type of casing: PVC 40

Screen length: 5' feet Screen diameter: 2 inches Type of screen: PVC wrapal

Screen slot size: 8 inches Setting depth: From 67 feet to 72 feet

Type of completion (circle all applicable): Gravel packed Underreamed Telescoped Open hole Natural Development
 Other (describe): _____

Top of lap pipe or reduction in casing: _____ feet. If telescoped or more than one screen, describe on back of page

Logs run (circle all applicable): No log run Electric Gamma Ray Density Sonic Neutron Other: _____

Name of organization running log(s): _____

I certify that the well was drilled, constructed, and completed in accordance with all applicable requirements of the Mississippi Department of Environmental Quality and/or the Mississippi Department of Health regulations and state laws.

Michael R Fry 0468 Michael R Fry
 BY: OLWR

RECEIVED
 BY: OLWR

GROUND LEVEL


DESCRIPTION OF FORMATIONS ENCOUNTERED

FROM TO

sand	0	15
sand & clay	15	30
clay	30	42
sand & clay	42	60
sand coarse	60	72

If more than one screen, show location of each on sketch

Sketch the property layout and include the following: 1) the well location; 2) any permanent structures on the property that may aid in locating the well; 3) any roads, power lines, or other items that may aid in locating the property and the well; 4) indicate direction.

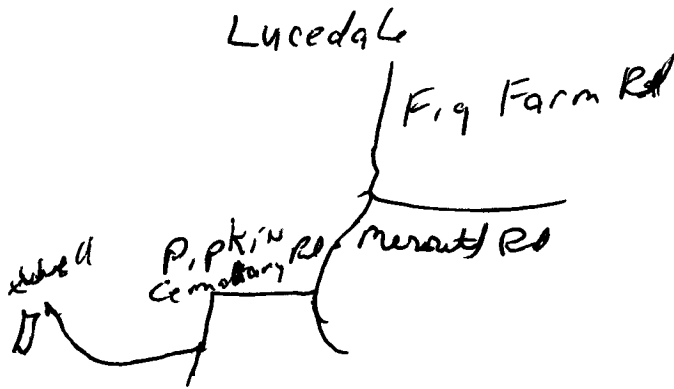

Landowner Name: David Wilson

Signature of Water Well Contractor: Michael R. Fryfoff

RECEIVED
OCT 29 2007
BY: OLWR

STATE WELL REPORT

Part 2

Pump Installer's Completion Report

County: Scott
 Permit #: _____
 Driller: Mike J. Woods
 Date completed: 10-9-07

Mississippi Department of Environmental Quality
 Office of Land and Water Resources
 P.O. Box 10631
 Jackson, MS 39289-0631
 (601)961-5210
 (601)354-6938 (fax)

For Office Use Only:

Aquifer: _____
 Well #: B-82
 Elevation: _____

This report must be prepared by the pump installer in detail and filed with the Department within 30 days of the installation of pump. A copy of Part 1 of this report must be attached to this report.

Well Owner Information	Well Location
Owner Name: <u>David Wilson</u>	Latitude: <u>30-55-28.7</u> Longitude: <u>088-38-28.8</u>
Mailing Address: <u>118 Louis Ln</u>	Method of Lat/Long (circle one): Conventional Survey, USGS quad, <u>Hand-held GPS</u> , Survey-grade GPS
<u>Lucedale</u> <u>MS</u> <u>39452</u>	1/4 _____ 1/4 Sec <u>36</u> Twn <u>T15</u> Rng <u>R7W</u>
City State Zip Code	Distance Direction Nearest Town
Telephone No. () _____	<u>2</u> Miles <u>W</u> of <u>Lucedale</u>

Pump Type Circle one	Power Type Circle one
Air Lift <input type="radio"/> Jet <input checked="" type="radio"/> Submersible	Diesel Engine Gasoline Engine Natural Gas
Bucket <input type="radio"/> Piston <input type="radio"/> Turbine	<input checked="" type="radio"/> Electric Motor <input type="radio"/> Hand <input type="radio"/> Tractor PTO
Centrifugal <input type="radio"/> Rotary <input type="radio"/> Flowing Well	Windmill Other (specify): _____
Other (specify): _____	Horse Power Rating of Motor: <u>1</u>
Date Pump Installed: <u>10-9-07</u>	Setting Depth: <u>65</u> feet
Rated Pump Capacity: <u>8-12</u> Gallons Per Minute	Number of Stages: <u>2</u>

Pump Test Data	Method of Measuring Water Level Circle one
Date Well Tested: _____	<input checked="" type="radio"/> Air Line <input type="radio"/> Electric Measuring Line <input type="radio"/> Steel Tape
Static Water Level (A): <u>50</u> Feet Below Land Surface	Other (specify): _____
Pumping Water Level (B): <u>60</u> Feet Below Land Surface	For flowing well, measured shut in head: _____ feet
Drawdown [(B) - (A)]: <u>10</u> Feet Below Land Surface	Well yielded <u>7</u> GPM with a drawdown of
Test Pumping Rate: <u>7</u> Gallons Per Minute	<u>10</u> feet after <u>1 1/2</u> hours of pumping
Duration of Pump Test (minimum 4 hours): <u>4</u> hours	

I HEREBY CERTIFY that the above statements are true to the best of my knowledge.

Michael R. Fry 09160408 Michael R. Fry
 Print Name of Pump Installer and License No. (if applicable) Signature of Pump Installer

OCT 29 2007
 BY: OLWR