

County: Deale
 Permit #: 0-780
 Driller: W. Joel Pierce
 Date drilling completed: 3-17-08

State Well Report
Part 1 - Driller's Log

Mississippi Department of Environmental Quality
 Office of Land and Water Resources
 P.O. Box 10631
 Jackson, MS 39289-0631
 (601)961-5210
 (601)354-6938 (fax)

For Office Use Only:
 Aquifer: _____
 Well #: B-86
 L.S. Elevation: _____
 E-log #: _____

State Law requires that this report be prepared by the license holder responsible for the work and filed with the Department at the above address within 30 days of completion of drilling of the well or borehole.

Information on Well Owner <small>(Landowner if borehole is not for a water well)</small>	Well or Borehole Location
Owner Name: <u>Nicole Hany</u>	Latitude: <u>88° 39' 78" N</u> Longitude: <u>30° 57' 316" W</u>
Mailing Address: <u>120 Hany Lane</u>	Method of Lat/Long (circle one): Conventional Survey
<u>Beverly Rd</u>	USGS quad, Hand-held GPS, Survey-grade GPS
<u>Lumbah MS 38952</u>	<u>Dist 1/4 Sec 23 Twn 15 Rng 7W</u>
City State Zip Code	<u>SW SW 14</u>
Telephone No. <u>(601) 508-1878</u>	Distance Direction Nearest Town
	<u>4 Miles West of Lumbah, MS</u>

Well / Borehole Data

Date drilling started: 3-17-08 Date drilling completed: 3-17-08 Hole depth: 80 Hole diameter: 2

Location of the source of any surface water used for drilling: Aquela, MS

Method of dosing and volume of Chlorine used in drilling and development: 2000 Water 4000 Chlorine

Logs run (circle all applicable): No log run Electric Gamma Ray Density Sonic Neutron Other: _____

Name of organization running log(s): _____

Purpose of borehole (check one): Water Well Geotechnical/Geological Investigation _____ Ground Source Heat Pump _____

Seismic Survey _____ Other (describe) _____

If drilling is not related to water well construction, skip the remainder of this block

Purpose of Well (check one): Home Industrial _____ Public Supply _____ Irrigation _____ Fish Culture _____ Other: _____

If a flowing well, method of flow regulation: Valve _____ Other (describe) _____

Static Water Level: 5 feet above or below (circle one) land surface Date measured: 3-12-08

Method of Measurement (circle one) steel tape electric tape air line other: _____

Well depth: 80 Well grouted to a depth of 10 feet Type of grout (circle one): Neat Cement Bentonite Mix

Casing length: 70 feet Casing diameter: 2 inches Type of casing: Sch 40 Plaster

Screen length: 10 feet Screen diameter: 2 inches Type of screen: Sch 80 "

Screen slot size: 6 inches Setting depth: From 0 feet to 80 feet

Type of completion (circle all applicable): Gravel packed Underreamed Telescoped Open hole Natural Development

Other (describe): _____


Top of lap pipe or reduction in casing: _____ feet. *If telescoped or more than one screen, describe on next page*

Form: OLWR-SWR-1A

RECEIVED
 APR 17 2008
 BY: OLWR

The sketch below only required for water wells

If well telescopes, show depths on sketch.

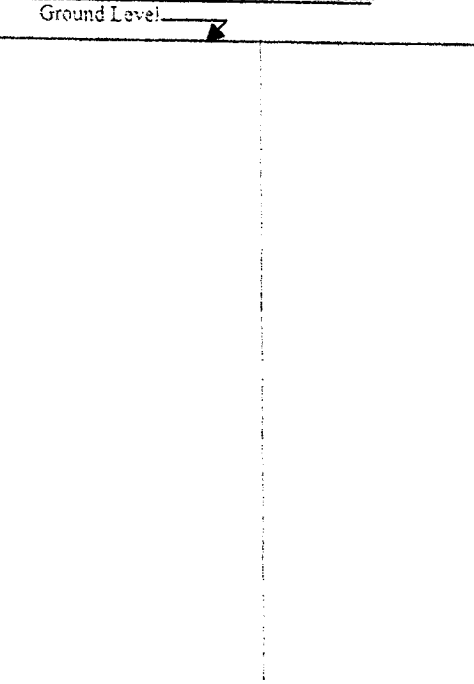


Description of formations encountered must be provided for all wells and boreholes, unless specifically exempted by regulation.

Description of Formations Encountered	From (depth Ground Level)	To (depth)
Red Sand	0	15
yellow clay	15	25
white sand	25	80

If more than one screen, show location of each on sketch

Sketch the property layout and include the following: 1) the well location; 2) any permanent structures on the property that may aid in locating the well; 3) any roads, power lines, or other items that may aid in locating the property and the well; 4) a north arrow.

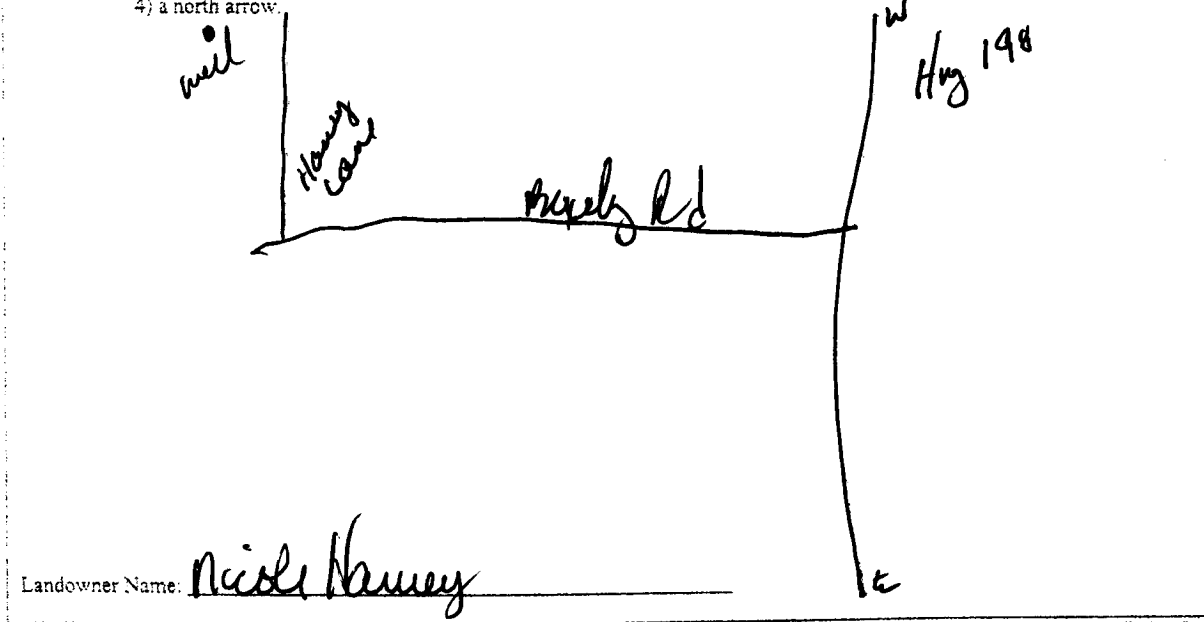

Landowner Name: Missie Hanney

I certify that the well/borehole was drilled, constructed, and completed in accordance with all applicable requirements of the Mississippi Department of Environmental Quality and the Mississippi Department of Health regulation, if applicable, and state laws.

Joel Pien 0-780 3-17-08
 Print Name of Responsible Licensee and License No. Date

Joel Pien
 Signature of Licensee

RECEIVED
 APR 17 2008
 BY: OLWR

STATE WELL REPORT

Part 2

Pump Installer's Completion Report
 Mississippi Department of Environmental Quality
 Office of Land and Water Resources
 P.O. Box 10631
 Jackson, MS 39289-0631
 (601)961-5210
 (601)354-6938 (fax)

Country: Mississippi
 Permit #: 0-780
 Driller: W. Joel Pierre
 Date completed: 3-17-08
Copy information from block on Part 1

For Office Use Only:

Aquifer: _____
 Well #: B-86
 Elevation: _____

This part of the report must be completed by a licensed water well contractor or a licensed pump installer. A copy of Part 1 of the report must be attached and both parts filed with the Department at the above address within 30 days of well completion.

Well Owner Information	Well Location
Owner Name: <u>Nick Harvey</u>	Latitude: <u>88-39 798</u> Longitude: <u>30 57-316</u>
Mailing Address: <u>120 Harvey Lane</u>	Method of Lat/Long (check one): Conventional Survey _____
<u>Lumbah, ms</u> <u>39452</u>	USGS quad _____, Hand-held GPS <input checked="" type="checkbox"/> , Survey-grade GPS _____
City State Zip Code	<u>nw</u> ¼ <u>nw</u> ¼ Sec <u>23</u> T <u>15</u> R <u>7a</u>
Telephone No. <u>(601) 508-1878</u>	Distance Direction Nearest Town
	<u>4</u> Miles <u>west</u> of <u>Lumbah, ms</u>

Pump Type Circle one	Power Type Circle one
Air Lift <input checked="" type="radio"/> Jet Submersible	Diesel Engine Gasoline Engine Natural Gas
Bucket Piston Turbine	<input checked="" type="radio"/> Electric Motor Hand Tractor PTO
Centrifugal Rotary Flowing Well	Windmill Other (specify): _____
Other (specify): _____	Horse Power Rating of Motor: <u>1 hp</u>
Date Pump Installed: <u>3-17-08</u>	Setting Depth: <u>30 let line</u> feet
Rated Pump Capacity: <u>10</u> Gallons Per Minute	Number of Stages: <u>2</u>

Pump Test Data	Method of Measuring Water Level Circle one
Date Well Tested: <u>3-17-08</u>	<input checked="" type="radio"/> Air Line Electric Measuring Line Steel Tape
Static Water Level (A): <u>5</u> Feet Below Land Surface	Other (specify): _____
Pumping Water Level (B): <u>50</u> Feet Below Land Surface	For flowing well, measured shut in head: _____ feet
Drawdown [(B) - (A)]: <u>2</u> Feet Below Land Surface	Well yielded <u>10</u> GPM with a drawdown of
Test Pumping Rate: <u>10</u> Gallons Per Minute	<u>2</u> feet after <u>48</u> hours of pumping
Duration of Pump Test (minimum 4 hours): <u>48</u> hours	

I HEREBY CERTIFY that the above statements are true to the best of my knowledge.

Joel Pierre 0-780 Joel Pierre
 Print Name of Pump Installer and License No. (if applicable) Signature of Pump Installer

Form: OLWR-SWR-1B

RECEIVED

APR 17 2008

BY: OLWR