


GEORGE  
B 2001  
12-16-75

MISSISSIPPI  
BOARD OF WATER COMMISSIONERS  
416 North State Street  
Jackson, Mississippi 39201

WATER WELL DRILLERS LOG

12-16 1975 M & H Well Co. GEORGE  
date well completed firm name county well located

LANDOWNER: EDWARD RICH	description of formations encountered	from	to
2 CEDALE MISS	DIRT	1	2
(mailing address)	RED CLAY	2	15
WELL LOCATION:	SURFACE SAND	15	18
sec. 27 T1 N R 7 E	BROWN & WHITE CLAY	18	60
6 miles S E of CEDALE	SAND	60	65
(distance) (direction) (nearest town)	BLUE CLAY	65	160
WELL PURPOSE: HOME	SILK SAND	160	180
(home, irrigation, municipal, industrial)	BLUE CLAY	180	200
WELL COMPLETION DATA:	SAND	200	220
(1) diameter (inches) 2"	SAND & GRAVEL	220	224
(2) total depth (feet) 204'			
(3) static water level (feet) 60' below top of ground.			
(4) casing PLASTIC, 200' (material) (depth)			
(size) if telescope see back.			
(5) screen 4' 200' (length) (depth to top)			
2" PLASTIC (size) (material)			
(6) pump 1 7 (HP) (yield gpm)			
ELECTRIC (type power)			
(7) electric log NO (yes or no)			
(organization running log)			
(8) how well bottom plugged BACH WASH VALVE			
DRILLERS REMARKS:			

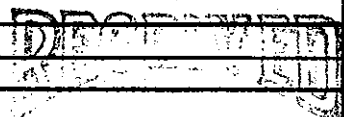

MAR 10 1976