


GEORGE  
R 9033  
1/27/80

MISSISSIPPI  
BOARD OF WATER COMMISSIONERS  
416 North State Street  
Jackson, Mississippi 39201

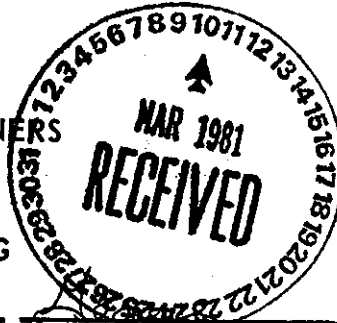

WATER WELL DRILLERS LOG

1-27-80 date well completed 19 Engle Well Service firm name county well located

LANDOWNER:	description of formations encountered	from	to
<p>Address CARY Eubanks Warrant (mailing address)</p>			
<p>WELL LOCATION: sec. 18 T. 1 N. R. 7 E 4 miles N of Lucedale (distance) (direction) (nearest town)</p>	<p>Topsoil 0 5 Sand 5 18 Clay 18 22 course SAND 22 46 Blue Clay 46 96 Fine SAND 96 100 Red SAND 100 110 red Sand 110 130</p>		
<p>WELL PURPOSE: (home, Irrigation, municipal, Industrial)</p>	SAND HAD A PINK COLOR		
<p>WELL COMPLETION DATA: 1-27-80</p>			
(1) diameter (inches) 2"			
(2) total depth (feet) 130'			
(3) static water level (feet) 90' below top of ground.			
(4) casing PVC @ 110' (material) (depth) 2" (size) if telescope see back.			
(5) screen 20' 110' (length) (depth to top) 2" PVC (size) (material)			
(6) pump 1 5 (HP) (yield gpm) E/E (type power)			
(7) electric log (yes or no)			
(organization running log)			
(8) how well bottom plugged 2" PVC Backwash			
DRILLERS REMARKS: Poor			

