

ERS

GEORGE WATER WELL DRILLING LOG

C11

C35

Date: 8-10-60 10, 1960, Driller: Jim P. Moran County: Franklin
(Name)

(1) Owner of Land: <u>E. C. Rogers</u> (Name)	Description & Color of Materials Sand, Clay, Red Clay, Shell, etc.	Thick- ness Feet	Depth Feet
<u>Rt. #4 Lucedale Miss.</u> (Address)	<u>clay</u>	<u>60</u>	
(2) Location: <u>SW 1/4, NE 1/4, Sec. 24 T15R6W</u>	<u>Sand</u>	<u>14</u>	<u>74</u>
<u>4</u> miles <u>NE</u> , of <u>Lucedale</u> , (distance) (direction) (Nearest Town)			
(3) Topography: <u>Hilly</u> (Hilly) (Flat) (Level)			
(4) Purpose of Well: <u>Livestock</u> (Domestic Irrigation Municipal, Industrial, Other)			


Information upon completion of well:

- (1) Diameter: 2 inches.
- (2) Total Depth: 74 feet.
- (3) Water Level: 60 feet below top of ground.
- (4) Cased to: 719, Size 3x2.
- (5) Screen: Size #60, Length 4.
- (6) Were any formations sealed against pollution?
 yes, no.

If YES depth of formation: _____

Why: _____

Drillers Remarks: _____

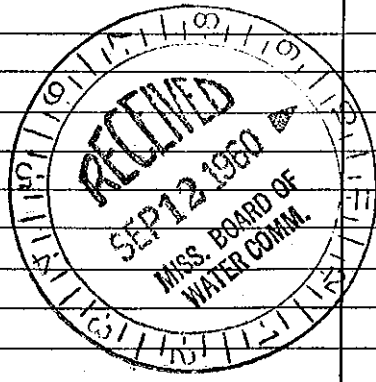

Well No.

(Use Back Side)

Mail this copy to Board of Water Commissioners 429 Miss. St. Jackson, Miss.