

# State Well Report

## Part 1

Mississippi Department of Environmental Quality  
 Office of Land and Water Resources  
 P.O. Box 10631  
 Jackson, MS 39289-0631  
 (601)961-5210  
 (601)354-6938 (fax)

For Office Use Only:

Aquifer: \_\_\_\_\_  
 Well #: C-117  
 L. S. Elevation: \_\_\_\_\_  
 E-log #: \_\_\_\_\_

County: George 159  
 Permit #: \_\_\_\_\_  
 Driller: Mike & Wade  
 Date drilling completed: 4-8-05

*Fry's Eagle Water Well Service*  
 State Law requires that this report be prepared by the driller in detail and filed with the Department within 30 days of completion of drilling of the well.

Well Owner Information		Well Location	
Owner Name: <u>Art Gallon</u>	Latitude: <u>30.57.081N</u>	Longitude: <u>88.36.688W</u>	
Mailing Address: <u>136 Perry Gallon Rd</u>	Method of Lat/Long (circle one): Conventional Survey.		
<u>Lucedal</u> <u>Ms</u> <u>39452</u>	USGS quad, Hand-held GPS, Survey-grade GPS <input checked="" type="checkbox"/>		
City State Zip Code	NW 1/4 NW 1/4 Sec <u>20</u> Twn <u>T15</u> Rng <u>R6W</u>		
Telephone No. ( ) _____	Distance <u>2</u> Miles	Direction <u>N 2</u> of	Nearest Town <u>Lucedal</u>

**Well Data**

Purpose of Well (circle one) Home Industrial Public Supply Irrigation Fish Culture Other: \_\_\_\_\_

Date well drilling started: 4-8-05 Date well drilling completed: 4-8-05

If flowing, method of flow regulation: Valve \_\_\_\_\_ Other (describe) \_\_\_\_\_

Static Water Level: 37 feet above or below (circle one) land surface Date measured: 4-8-05

Method of Measurement (circle one) steel tape electric tape air line other: \_\_\_\_\_

Hole depth: 50 Well depth: 50 Well grouted to a depth of 10 feet

Type of grout (circle one): Cement Bentonite Mix

Casing length: 40 feet Casing diameter: 4 inches Type of casing: PVC 40

Screen length: 10 feet Screen diameter: 4 inches Type of screen: PVC wrapped

Screen slot size: 10 inches Setting depth: From 40 feet to 50 feet

Type of completion (circle all applicable): Gravel packed Underreamed Telescoped Open hole Natural Development

Other (describe): \_\_\_\_\_

Top of lap pipe or reduction in casing: \_\_\_\_\_ feet. If telescoped or more than one screen, describe on back of page

Logs run (circle all applicable): No log run Electric Gamma Ray Density Sonic Neutron Other: \_\_\_\_\_

Name of organization running log(s): \_\_\_\_\_  
 I certify that the well was drilled, constructed, and completed in accordance with all applicable requirements of the Mississippi Department of Environmental Quality and/or the Mississippi Department of Health regulations and state laws.

Michael R Fry Eagle 0408 Michael R Fry 0408  
 Print Name of Water Well Contractor and License No. Signature of Water Well Contractor

RECEIVED  
 APR 19 2005  
 BY: OLWR

If well telescopes please sketch below and show depths.


C-117

Ground Level

Description of Formations Encountered	From	To
Top sand	0	2
sand	2	10
Clay	10	16
sand	16	23
Clay	23	35
sand	35	50

If more than one screen, show location of each on sketch

Sketch the property layout and include the following: 1) the well location; 2) any permanent structures on the property that may aid in locating the well; 3) any roads, power lines, or other items that may aid in locating the property and the well; 4) indicate direction.

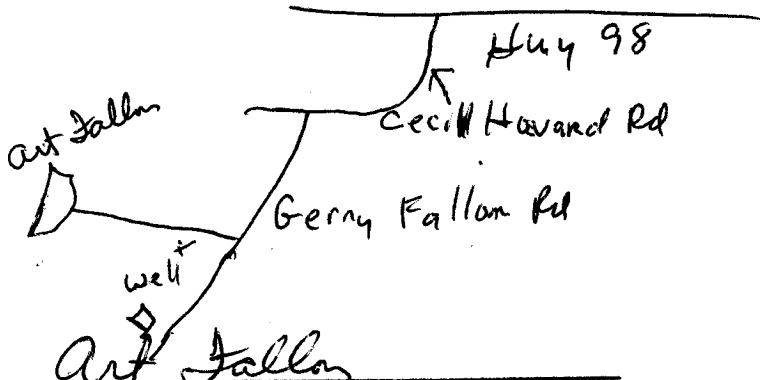

Landowner Name: Art Fallon

Michael R. Juyfel 0408  
 Signature of Water Well Contractor

RECEIVED  
 APR 19 2005  
 BY: OLWR

# STATE WELL REPORT

## Part 2

**Pump Installer's Completion Report**  
 Mississippi Department of Environmental Quality  
 Office of Land and Water Resources  
 P.O. Box 10631  
 Jackson, MS 39289-0631  
 (601)961-5210  
 (601)354-6938 (fax)

For Office Use Only:

Aquifer: \_\_\_\_\_

Well #: C-117

Elevation: \_\_\_\_\_

County: George  
 Permit #: \_\_\_\_\_  
 Driller: Mike & Wade  
 Date completed: 4-11-05

**This report should be prepared by the pump installer in detail and filed with the Department within 30 days of the installation of pump.**

Well Owner Information	Well Location
Owner Name: <u>Art Fallon</u>	Latitude: <u>30-57-08N</u> Longitude: <u>088-36-65W</u>
Mailing Address: <u>136 Jerry Fallon Rd</u>	Method of Lat/Long (circle one): Conventional Survey,
<u>Lucedal Ms 39452</u>	USGS quad, <u>Hand-held GPS</u> Survey-grade GPS
City State Zip Code	¼ Sec <u>20</u> Twn <u>T15</u> Rng <u>R5W</u>
Telephone No. ( ) _____	Distance Direction Nearest Town
	<u>2</u> Miles <u>N</u> of <u>Lucedal</u>

Pump Type Circle one	Power Type Circle one
Air Lift Jet <u>Submersible</u>	Diesel Engine Gasoline Engine Natural Gas
Bucket Piston Turbine	<u>Electric Motor</u> Hand Tractor PTO
Centrifugal Rotary Flowing Well	Windmill Other (specify): _____
Other (specify): _____	Horse Power Rating of Motor: <u>1/2</u>
Date Pump Installed: <u>4-11-05</u>	Setting Depth: <u>50</u> feet
Rated Pump Capacity: <u>10</u> Gallons Per Minute	Number of Stages: <u>8</u>

Pump Test Data	Method of Measuring Water Level Circle one
Date Well Tested: <u>4-11-05</u>	<u>Air Line</u> Electric Measuring Line Steel Tape
Static Water Level (A): <u>37</u> Feet Below Land Surface	Other (specify): _____
Pumping Water Level (B): <u>47</u> Feet Below Land Surface	For flowing well, measured shut in head: _____ feet
Drawdown [(B) - (A)]: <u>10</u> Feet Below Land Surface	Well yielded <u>15</u> GPM with a drawdown of
Test Pumping Rate: <u>15</u> Gallons Per Minute	<u>10</u> feet after <u>1 1/2</u> hours of pumping
Duration of Pump Test (minimum 4 hours): <u>4</u> hours	

I HEREBY CERTIFY that the above statements are true to the best of my knowledge.

Michael R Fayfogel 0408  
 Print Name of Pump Installer and License No. (if applicable)

Michael R Fayfogel 0408  
 Signature of Pump Installer

RECEIVED  
 APR 19 2005  
 BY: OLWR