

County: George  
 Permit #: \_\_\_\_\_  
 Driller: Michael S. Harvard  
 Date drilling completed: 12-13-07

**State Well Report**  
**Part 1 - Driller's Log**

Mississippi Department of Environmental Quality  
 Office of Land and Water Resources  
 P.O. Box 10631  
 Jackson, MS 39289-0631  
 (601)961-5210  
 (601)354-6938 (fax)

**For Office Use Only:**  
 Aquifer: \_\_\_\_\_  
 Well #: C-146  
 L. S. Elevation: \_\_\_\_\_  
 E-log #: \_\_\_\_\_

*State Law requires that this report be prepared by the license holder responsible for the work and filed with the Department at the above address within 30 days of completion of drilling of the well or borehole.*

Information on Well Owner (Landowner if borehole is not for a water well)	Well or Borehole Location
Owner Name: <u>Pro-lawn Main.</u>	Latitude: <u>30° 57-228"</u> Longitude: <u>88° 44-422"</u>
Mailing Address: <u>1017 Winter Street</u>	<u>56 58</u> <u>34 49</u> Method of Lat/Long (circle one): Conventional Survey,
<u>Lucedale</u> MS <u>39452</u>	USGS quad, <u>hand-held GPS</u> Survey-grade GPS
City                      State                      Zip Code	<u>SW 1/4 NW 1/4</u> Sec <u>22</u> Twn <u>T15</u> Rng <u>R6W</u>
Telephone No. <u>(601) 947-8070</u>	Distance                      Direction                      Nearest Town <u>1</u> Miles <u>N</u> of <u>Lucedale</u>

**Well / Borehole Data**

Date drilling started: 12-13-07 Date drilling completed: 12-13-07 Hole depth: 365 Hole diameter: 4 1/4

Location of the source of any surface water used for drilling: \_\_\_\_\_  
 Method of dosing and volume of Chlorine used in drilling and development: \_\_\_\_\_

Logs run (circle all applicable): (No log run) Electric Gamma Ray Density Sonic Neutron Other: \_\_\_\_\_  
 Name of organization running log(s): \_\_\_\_\_

Purpose of borehole (check one): Water Well \_\_\_\_\_ Geotechnical/Geological Investigation \_\_\_\_\_ Ground Source Heat Pump \_\_\_\_\_  
 Seismic Survey \_\_\_\_\_ Other (describe) test hole

*If drilling is not related to water well construction, skip the remainder of this block*

Purpose of Well (check one): Home \_\_\_\_\_ Industrial \_\_\_\_\_ Public Supply \_\_\_\_\_ Irrigation \_\_\_\_\_ Fish Culture \_\_\_\_\_ Other: \_\_\_\_\_

If a flowing well, method of flow regulation: Valve \_\_\_\_\_ Other (describe) \_\_\_\_\_

Static Water Level: \_\_\_\_\_ feet above or below (circle one) land surface Date measured: \_\_\_\_\_

Method of Measurement (circle one) steel tape electric tape air line other: \_\_\_\_\_

Well depth: \_\_\_\_\_ Well grouted to a depth of \_\_\_\_\_ feet Type of grout (circle one): Neat Cement Bentonite Mix

Casing length: \_\_\_\_\_ feet Casing diameter: \_\_\_\_\_ inches Type of casing: \_\_\_\_\_

Screen length: \_\_\_\_\_ feet Screen diameter: \_\_\_\_\_ inches Type of screen: \_\_\_\_\_

Screen slot size: \_\_\_\_\_ inches Setting depth: From \_\_\_\_\_ feet to \_\_\_\_\_ feet

Type of completion (circle all applicable): Gravel packed Underreamed Telescoped Open hole Natural Development  
 Other (describe): \_\_\_\_\_

Top of lap pipe or reduction in casing: \_\_\_\_\_ feet. *If telescoped or more than one screen, describe on next page*

Form: OLWR-SWR-1A


RECEIVED  
 JAN 07 2008  
 BY: OLWR

C-146

The sketch below only required for water wells

If well telescopes, show depths on sketch.

Ground Level →

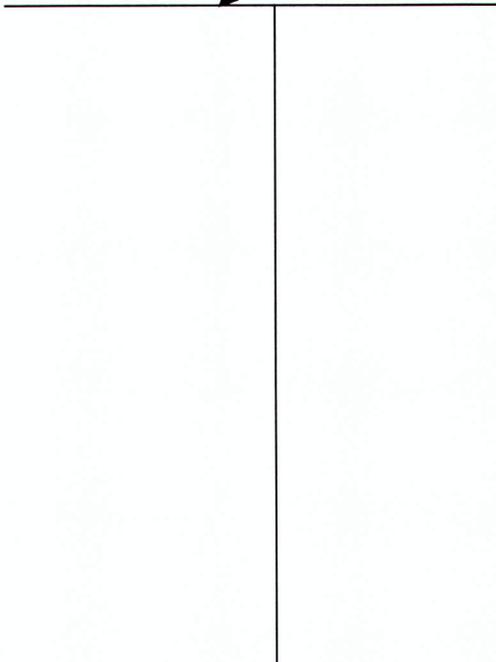


Description of formations encountered must be provided for all wells and boreholes, unless specifically exempted by regulations

Description of Formations Encountered	From (depth) To (depth)	
	Ground Level	
Top-sand	0	3
Clay	3	27
Sand (fine-med)	27	32
Clay	32	56
Sand (fine-med)	56	61
Sand (med)	61	79
Clay	79	98
Sand (med)	98	102
Clay	102	175
Sand (med)	175	178
Clay	178	273
Silt	273	285
Sand (fine-med)	285	289
Silt	289	295
Sand (fine-med)	295	299
Clay	299	315
Sand (fine-med)	315	318
Silt	318	335
Clay	335	348
Sand (med)	348	365

If more than one screen, show location of each on sketch

Sketch the property layout and include the following: 1) the well location; 2) any permanent structures on the property that may aid in locating the well; 3) any roads, power lines, or other items that may aid in locating the property and the well; 4) a north arrow.

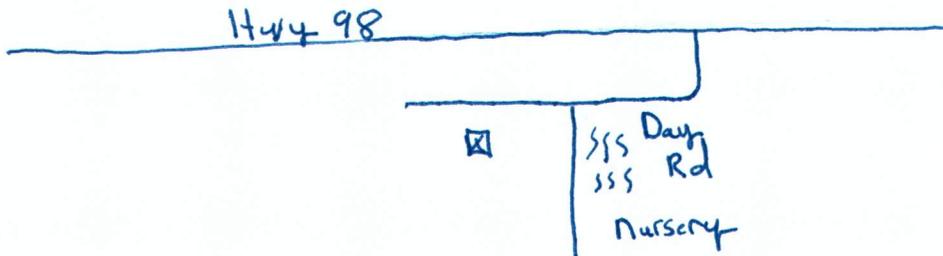

Landowner Name: Pro-Lawn Main.

Form: OLWR-SWR-1A

I certify that the well/borehole was drilled, constructed, and completed in accordance with all applicable requirements of the Mississippi Department of Environmental Quality and the Mississippi Department of Health regulations, if applicable, and state laws.

Michael S. Havard 0-673 12-27-07  
Print Name of Responsible Licensee and License No.      Date

Michael S. Havard  
Signature of Licensee

**RECEIVED**  
JAN 07 2008  
BY: OLWR