

County: George
 Permit #: _____
 Driller: Mike & Linda
 Date drilling completed: 7-2-10

State Well Report
Part 1 – Driller's Log
 Mississippi Department of Environmental Quality
 Office of Land and Water Resources
 P.O. Box 2307
 Jackson, MS 39225
 (601)961- 5210
 (601)961- 5228 (fax)

For Office Use Only:
 Aquifer: C 168
 Well #: _____
 L. S. Elevation: _____
 E-log #: _____

State Law requires that this report be prepared by the license holder responsible for the work and filed with the Department at the above address within 30 days of completion of drilling of the well or borehole.

Information on Well Owner (Landowner if borehole is not for a water well)	Well or Borehole Location
Owner Name: <u>Carl Evans</u>	Latitude: <u>30° 55' 51"</u> Longitude: <u>88° 34' 17"</u>
Mailing Address: <u>1143 Depot Rd</u>	Method of Lat/Long (circle one): Conventional Survey, _____ USGS quad, Hand-held GPS, Survey-grade GPS
<u>Lucedale MS 39452</u>	USGS quad, Hand-held GPS, Survey-grade GPS
City State Zip Code	<u>NW 1/4 SE 1/4 Sec 27 Twn 15 Rng R6W</u>
Telephone No. ()	Distance Direction Nearest Town <u>3/4</u> Miles <u>E</u> of <u>Lucedale</u>

Well / Borehole Data

Date drilling started: 7-2-10 Date drilling completed: 7-2-10 Hole depth: 90 Hole diameter: 7 1/2

Location of the source of any surface water used for drilling: NONE

Method of dosing and volume of Chlorine used in drilling and development: _____

Logs run (circle all applicable): No log run Electric Gamma Ray Density Sonic Neutron Other: _____

Name of organization running log(s): _____

Purpose of borehole (check one): Water Well ☒ Geotechnical/Geological Investigation _____ Ground Source Heat Pump _____

Seismic Survey _____ Other (describe) _____

If drilling is not related to water well construction, skip the remainder of this block

Purpose of Well (check one): Home ☒ Industrial _____ Public Supply _____ Irrigation _____ Fish Culture _____ Other: _____

If a flowing well, method of flow regulation: Valve _____ Other (describe) _____

Static Water Level: 45 feet above or below (circle one) land surface Date measured: _____

Method of Measurement (circle one) steel tape electric tape air line other: _____

Well depth: 90 Well grouted to a depth of 10 feet Type of grout (circle one): Neat Cement Bentonite Mix

Casing length: 80 feet Casing diameter: 4 inches Type of casing: PVC 40

Screen length: 10 feet Screen diameter: 4 inches Type of screen: PVC wrapped

Screen slot size: 10 inches Setting depth: From 80 feet to 90 feet

Type of completion (circle all applicable): Gravel packed Underreamed Telescoped Open hole Natural Development

Other (describe): _____

Top of lap pipe or reduction in casing: _____ feet. *If telescoped or more than one screen, describe on next page*

Form: OLWR-SWR-1A (04/08)


RECEIVED
 JUL 27 2010
 BY: OLWR

Ground Level_____

Description of Formations Encountered	From (depth)	To (depth)
---------------------------------------	--------------	------------

[illegible]

Sketch the property layout and include the following: 1) the well location; 2) any permanent structures on the property that may aid in locating the well; 3) any roads, power lines, or other items that may aid in locating the property and the well; 4) a north arrow.

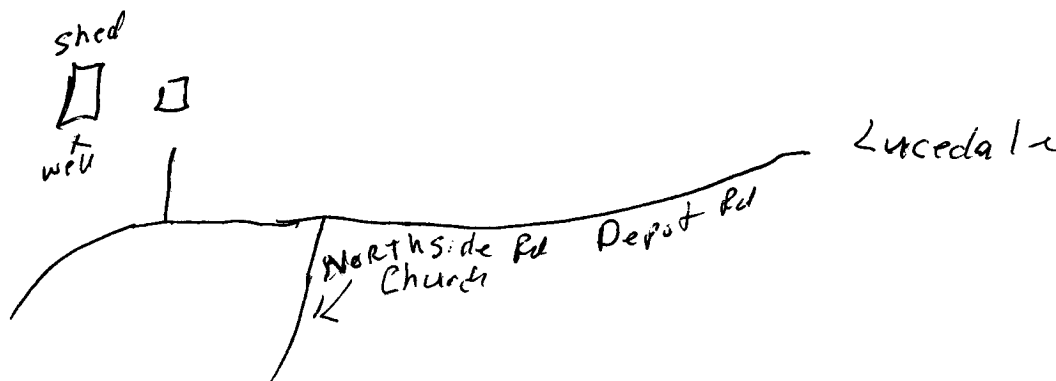

Landowner Name: Carl Evans

I certify that the well/borehole was drilled, constructed, and completed in accordance with all applicable requirements of the Mississippi Department of Environmental Quality and the Mississippi Department of Health regulations, if applicable, and state laws.

laws. Michael R Fry Fog/0408 7-2-10

Date

Michael R. Trefler

Signature of Licensee

RECEIVED

JUL 27 2010

BY: OLMP

STATE WELL REPORT

Part 2

Pump Installer's Completion Report
Mississippi Department of Environmental Quality
Office of Land and Water Resources
P.O. Box 2309
Jackson, MS 39225
(601)961-5210
(601)961-5228 (fax)

County: George

Permit #: _____

Driller: Mike Howard

Date completed: 7-2-10

Copy information from block on Part 1

For Office Use Only:

Aquifer: C168

Well #: _____

Elevation: _____

This part of the report must be completed by a licensed water well contractor or a licensed pump installer. A copy of Part 1 of the report must be attached and both parts filed with the Department at the above address within 30 days of well completion.

Well Owner Information	Well Location
Owner Name: <u>Carl Evans</u>	Latitude: _____ Longitude: _____
Mailing Address: <u>1143 Depot Rd</u>	Method of Lat/Long (check one): Conventional Survey _____
<u>Lucedale MS 39452</u>	USGS quad _____ Hand-held GPS _____ Survey-grade GPS _____
City State Zip Code	_____ 1/4 _____ 1/2 Sec <u>27</u> T <u>15</u> R <u>R6W</u>
Telephone No. (____) _____	Distance Direction Nearest Town
	<u>3/4</u> Miles <u>2</u> <u>Lucedale</u>

Pump Type Circle one	Power Type Circle one
Air Lift Jet <u>Submersible</u>	Diesel Engine Gasoline Engine Natural Gas
Bucket Piston Turbine	<u>Electric Motor</u> Hand Tractor PTO
Centrifugal Rotary Flowing Well	Windmill Other (specify): _____
Other (specify): _____	Horse Power Rating of Motor: <u>1 1/2</u>
Date Pump Installed: <u>7-2-10</u>	Setting Depth: <u>90</u> feet
Rated Pump Capacity: <u>27</u> Gallons Per Minute	Number of Stages: <u>10</u>

Pump Test Data	Method of Measuring Water Level Circle one
Date Well Tested: _____	<u>Air Line</u> Electric Measuring Line Steel Tape
Static Water Level (A): <u>45</u> Feet Below Land Surface	Other (specify): _____
Pumping Water Level (B): <u>65</u> Feet Below Land Surface	
Drawdown [(B) - (A)]: <u>20</u> Feet Below Land Surface	For flowing well, measured shut in head: _____ feet
Test Pumping Rate: <u>40</u> Gallons Per Minute	Well yielded <u>40</u> GPM with a drawdown of
Duration of Pump Test (minimum 4 hours): <u>4</u> hours	<u>20</u> feet after <u>1 1/2</u> hours of pumping

I HEREBY CERTIFY that the above statements are true to the best of my knowledge.

Michael R Fryfoyle 0408
Print Name of Pump Installer and License No. (if applicable)

Michael R Fryfoyle
Signature of Pump Installer

Form: OLWR-SWR-1B (04/08)

RECEIVED

JUL 27 2010

BY: OLWR