

GEORGE
C 7014
3-6-81

MISSISSIPPI
BOARD OF WATER COMMISSIONERS
416 North State Street
Jackson, Mississippi 39201

WATER WELL DRILLERS LOG

3-6-81 date well completed 1981 Englewell Service firm name ~~George~~ George county well located

LANDOWNER: Floyd Whitley
RT 8
Lucedale, MS
(mailing address)


WELL LOCATION:
27th sec. 1 T 1 N R 6 E
S W
1 miles N of Lucedale
(distance) (direction) (nearest town)

WELL PURPOSE:
(home Irrigation, municipal, industrial)

WELL COMPLETION DATA: 3-6-81

- (1) diameter (inches) 2"
- (2) total depth (feet) 87'
- (3) static water level (feet) 32' ^{below} above top of ground.
- (4) casing PVC 77' (material) (depth)
2" (size) if telescope see back.
- (5) screen 10' 77' (length) (depth to top)
2" (size) PVC (material)
- (6) pump 1 (HP) 10 (yield gpm)
EK (type power)
- (7) electric log (yes or no) (no)
- (organization running log)
- (8) how well bottom plugged 2" PVC
Back wash

description of formations encountered	from	to
Top Soil	0	10
Sand	10	30
Clay	30	32
Sand	32	60
Clay	60	87
Coarse Sand yellow Clay	70	87

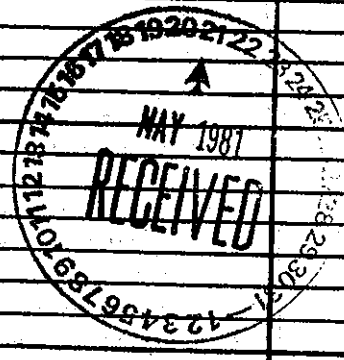

DRILLERS REMARKS: