

~~XXXXXXXXXX~~ **GEORGE** 3 R
WATER WELL DRILLERS LOG

D6
 8-12-60

~~301~~ D13

Date: 8/12, 1960, Driller: Jim Piro County: Floyd
 Elev. 240 (Name)

(1) Owner of Land:	Description & Color of Materials Sand, Clay, Red Clay, Shell, etc.	Thick- ness Feet	Depth Feet
Fred Boone (Name) Route 4 Lucedale Miss (Address)	Clay Sand	17 30	47
(2) Location: SE 1/4, SE 1/4, Sec 20 T4 R5W			
5 miles East of Lucedale (distance) (direction) (Nearest Town)			
(3) Topography: Hilly (Hilly) (Flat) (Level)			
(4) Purpose of Well: Home (Domestic Irrigation Municipal, Industrial, Other)			

Information upon completion of well:

(1) Diameter 9 1/2 inches.

(2) Total Depth 47 feet.

(3) Water Level 30 feet below top of ground.

(4) Cased to _____, Size _____


(5) Screen: Size 60, Length 4' x 60 ga.

(6) Were any formations sealed against pollution?
 _____ yes, _____ no.

If YES depth of formation _____

Why _____

Drillers Remarks: _____

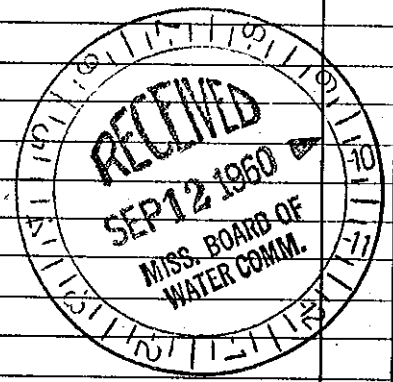

Well No.

(Use Back Side)

Retain this copy for your office files.