

GEORGE
LD9
10-7-60

MISSISSIPPI BOARD OF WATER COMMISSIONERS

WATER WELL DRILLERS LOG

~~10-7-60~~
D-4

Date: October 7, 1960, Driller: Hattiesburg Butane Co. County George

(Name)

(1) Owner of Land: <u>Quinton D. Merritt</u> (Name)	Description & Color of Materials Sand, Clay, Red Clay, Shell, etc.	Thick- ness Feet	Depth Feet
<u>Route 4, Lucedale, Miss.</u> (Address)	Red Sand		0-25
(2) Location: <u>N.E. 1/4, N.W. 1/4, Sec. 32 T15 RSW,</u> <u>3</u> miles <u>East</u> of <u>Lucedale</u> (distance) (direction) (Nearest Town)	White Sand		25-35
(3) Topography: <u>Level</u> (Hilly) (Flat) (Level)	White Clay		35-40
(4) Purpose of Well: <u>Domestic</u> (Domestic Irrigation Municipal, Industrial, Other)			


Information upon completion of well:

- (1) Diameter 2" inches.
- (2) Total Depth 40' feet.
- (3) Water Level 8' feet below top of ground.
- (4) Cased to _____, Size _____.
- (5) Screen: Size 2", Length 10'.
- (6) Were any formations sealed against pollution?
_____ yes, no.

If YES depth of formation _____

Why _____

Drillers Remarks: _____

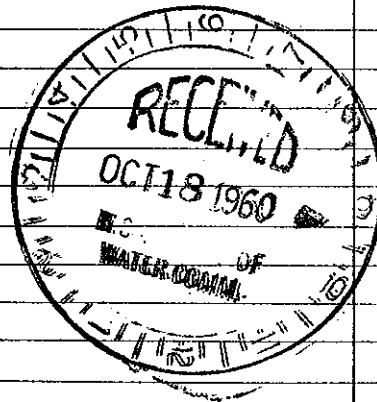

(Use Back Side)

Well No.

Mail this copy to Board of Water Commissioners 429 Miss. St. Jackson, Miss.