

George
~~DIA~~
 1-67

MISSISSIPPI BOARD OF WATER COMMISSIONERS

WATER WELL DRILLERS LOG


Finish Date: January, 1967, Driller: M & B Drilling Co. County: George
 (When well drilled) Well # 21 (Name) (Where well is located)

Rocky Creek Utilities
 (1) Owner of Land: (Name)
Lucedale, Miss.
 (Address)
 (2) Location: Highway 98, NW, SW, NE 32 1 to 5
1/4, 1/4, Sec. 12, T5, R10
2000 West 100th Ave. Lucedale
5 miles N East, of Lucedale,
 (distance) (direction) (Nearest Town)
 (3) Topography: Flat
 (Hilly) (Flat) (Level)
 (4) Purpose of Well: Community Water System
 (Domestic Irrigation, Municipal, Industrial, Other)

Description & Color of Materials Sand, Clay, Red Clay, Shell, etc.	Thick- ness Feet	Depth Feet
Surface Clay	25	25
Sand & Gravel	10	35
Clay	15	50
Sand & Clay	20	70
Sand	40	110
Sand & Clay	40	150
White Sand	15	165
Blue Clay, Circulation loss	73	238
Brown Sand	24	262
White & Brown Clay	21	283
Fine Sand	18	311
Coarse Sand	24	335
Blue Clay	35	370
Sand, Shells & Clay	33	403
Blue Clay	27	440
Coarse Grey Sand	55	495
Clay	5	500
Grey Sand	75	575
Chalk Break	2	577
Coarse Sand	48	625
Blue Clay	5	630
Bottom of Hole - 630		

Information upon completion of well:
350 FT 8" Cemented.
 (1) Diameter 6" inches.
Balance 6"
 (2) Total Depth 625 feet.
 (3) Water Level 190 feet below top of ground.
 (4) Cased to _____, Size _____
Cook - S.S.
 (5) Screen: Size 5/8" OD, Length 65 FT.
 (6) Were any formations sealed against pollution?
 _____ yes, _____ no.

If YES depth of formation _____
 Why _____
 Drillers Remarks: _____
 Yield in gpm: 325 gpm Pump - 15 FT
 Size pump: 40 HP Submersible Turbine
 Type power: 440 Volt 3 φ

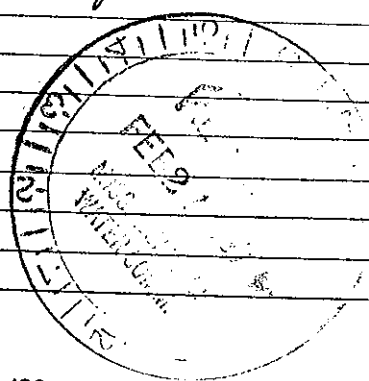

Mail this copy to Board of Water Commissioners 429 Miss. St. Jackson, Miss.
1165 ELEC. 302 ELEC. COG Chem Analysis