

County: George
 Permit #: 0-780
 Driller: W. Gael Pierce
 Date drilling completed: 1-15-07

State Well Report
Part 1 - Driller's Log

Mississippi Department of Environmental Quality
 Office of Land and Water Resources
 P.O. Box 10631
 Jackson, MS 39289-0631
 (601)961-5210
 (601)354-6938 (fax)

For Office Use Only:
 Aquifer: _____
 Well #: D-104
 L. S. Elevation: _____
 E-log #: _____

State Law requires that this report be prepared by the license holder responsible for the work and filed with the Department at the above address within 30 days of completion of drilling of the well or borehole.

Information on Well Owner <i>(Landowner if borehole is not for a water well)</i>	Well or Borehole Location
Owner Name: <u>Albert Reed</u>	Latitude: <u>88° 26' 698"</u> Longitude: <u>30° 59' 204"</u>
Mailing Address: <u>Dickinson Samml Rd</u>	Method of Lat/Long (circle one): Conventional Survey, <u>42</u>
<u>Luedale</u> <u>ms</u> <u>39452</u>	USGS quad: <u>Hand-held GPS</u> Survey-grade GPS
City State Zip Code	<u>NW</u> 1/4 <u>SW</u> 1/4 Sec. <u>4</u> Twn <u>15</u> Rng <u>5W</u>
Telephone No. () _____	Distance <u>12</u> Miles Direction <u>west</u> of <u>Luedale</u>

Well / Borehole Data

Date drilling started: 1-15-07 Date drilling completed: 1-15-07 Hole depth: 80 FT Hole diameter: 2 inch

Location of the source of any surface water used for drilling: Aquifer ms

Method of dosing and volume of Chlorine used in drilling and development: 4 cap chlorine 200 water

Logs run (circle all applicable): No log run Electric Gamma Ray Density Sonic Neutron Other: _____

Name of organization running log(s): _____

Purpose of borehole (check one): Water Well Geotechnical/Geological Investigation _____ Ground Source Heat Pump _____

Seismic Survey _____ Other (describe) _____

If drilling is not related to water well construction, skip the remainder of this block

Purpose of Well (check one): Home Industrial _____ Public Supply _____ Irrigation _____ Fish Culture _____ Other: _____

If a flowing well, method of flow regulation: Valve _____ Other (describe) _____

Static Water Level: 4 feet above of below (circle one) land surface Date measured: 1-15-07

Method of Measurement (circle one) steel tape electric tape air line other: _____

Well depth: 80 FT Well grouted to a depth of 10 feet Type of grout (circle one): Neat Cement Bentonite Mix

Casing length: 70 feet Casing diameter: 2 inches Type of casing: Plastic

Screen length: 10 feet Screen diameter: 2 inches Type of screen: 3h 80

Screen slot size: 8 slot inches Setting depth: From 0 feet to 80 feet
70 FT casing 10 FT Screen

Type of completion (circle all applicable): Gravel packed Underreamed Telescoped Open hole Natural Development

Other (describe): _____


Top of lap pipe or reduction in casing: _____ feet. *If telescoped or more than one screen, describe on next page*

Form: OLWR-SWR-1A

RECEIVED
 FEB 20 2007
 BY: OLWR

The sketch below only required for water wells

If well telescopes, show depths on sketch.

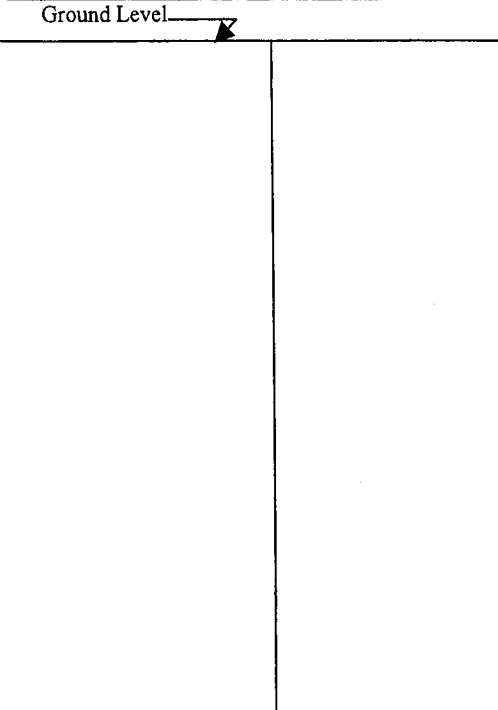


Description of formations encountered must be provided for all wells and boreholes, unless specifically exempted by regulations

Description of Formations Encountered	From (depth) To (depth)	
	Ground Level	
white clay	0	5
Blue clay	5	40
gray sand	40	80

If more than one screen, show location of each on sketch

Sketch the property layout and include the following: 1) the well location; 2) any permanent structures on the property that may aid in locating the well; 3) any roads, power lines, or other items that may aid in locating the property and the well; 4) a north arrow.

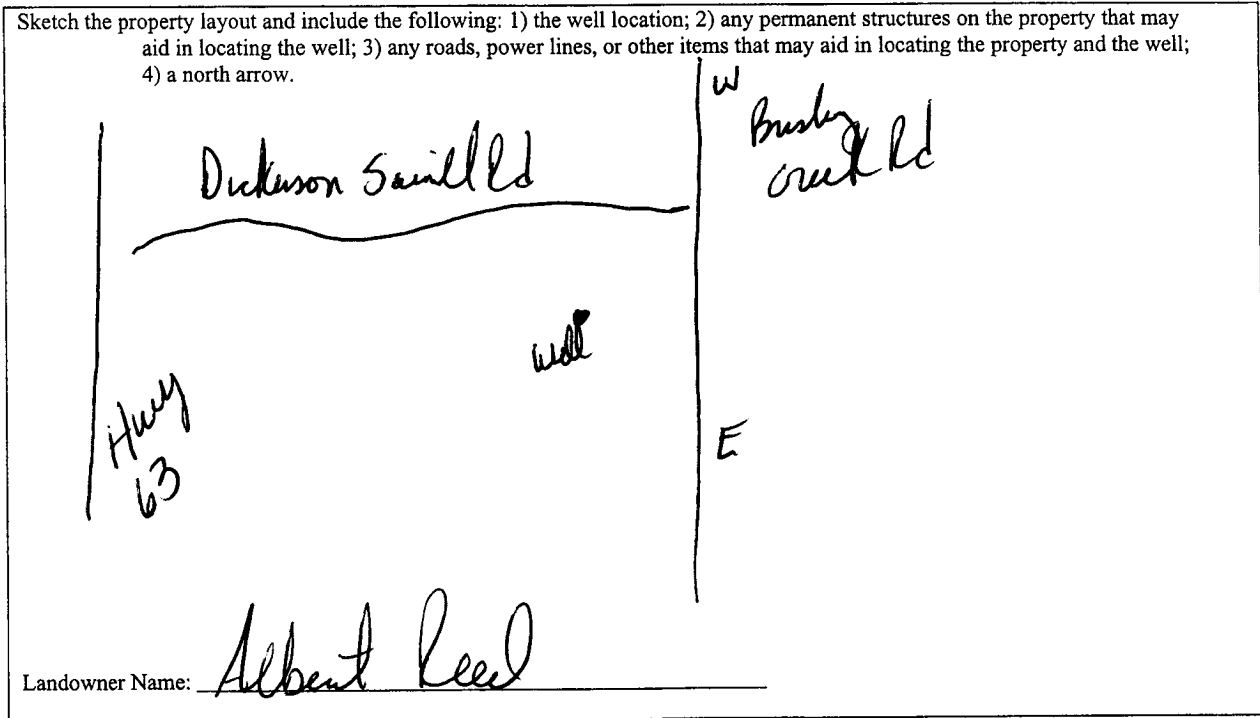


Form: OLWR-SWR-1A

I certify that the well/borehole was drilled, constructed, and completed in accordance with all applicable requirements of the Mississippi Department of Environmental Quality and the Mississippi Department of Health regulations, if applicable, and state laws.

JOEL PIERCE 0-780 1-13-07

Print Name of Responsible Licensee and License No. Date

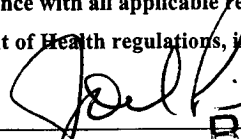
Signature of Licensee

RECEIVED

FEB 20 2007

BY: OLWR

STATE WELL REPORT

Part 2

Pump Installer's Completion Report
 Mississippi Department of Environmental Quality
 Office of Land and Water Resources
 P.O. Box 10631
 Jackson, MS 39289-0631
 (601)961-5210
 (601)354-6938 (fax)

County: George
 Permit #: 0-780
 Driller: W. Joel Pierce
 Date completed: 1-15-07
Copy information from block on Part 1

For Office Use Only:

Aquifer: _____
 Well #: D-104
 Elevation: _____

This part of the report must be completed by a licensed water well contractor or a licensed pump installer. A copy of Part 1 of the report must be attached and both parts filed with the Department at the above address within 30 days of well completion.

Well Owner Information	Well Location
Owner Name: <u>Albert Reed</u>	Latitude: <u>28 26 648</u> Longitude: <u>30 59 204</u>
Mailing Address: <u>Duckers Small/Budget</u>	Method of Lat/Long (check one): Conventional Survey _____ USGS quad _____, Hand-held GPS <input checked="" type="checkbox"/> , Survey-grade GPS _____
<u>Lumbah</u> <u>ms</u> <u>39452</u>	<u>NW</u> 1/4 <u>SW</u> 1/4 Sec <u>11</u> T <u>15</u> R <u>5W</u>
City State Zip Code	Distance Direction Nearest Town <u>12</u> Miles <u>west</u> of <u>Lumbah</u>
Telephone No. (____) _____	

Pump Type Circle one	Power Type Circle one
Air Lift <input type="radio"/> Jet <input checked="" type="radio"/> Submersible	Diesel Engine Gasoline Engine Natural Gas
Bucket <input type="radio"/> Piston <input type="radio"/> Turbine	<input checked="" type="radio"/> Electric Motor <input type="radio"/> Hand <input type="radio"/> Tractor PTO
Centrifugal <input type="radio"/> Rotary <input type="radio"/> Flowing Well	Windmill Other (specify): _____
Other (specify): _____	Horse Power Rating of Motor: <u>1</u>
Date Pump Installed: <u>1-15-07</u>	Setting Depth: <u>35 Ft inside jet</u> feet <u>line</u>
Rated Pump Capacity: <u>10</u> Gallons Per Minute	Number of Stages: <u>2</u>

Pump Test Data	Method of Measuring Water Level Circle one
Date Well Tested: <u>1-15-07</u>	<input checked="" type="radio"/> Air Line <input type="radio"/> Electric Measuring Line <input type="radio"/> Steel Tape
Static Water Level (A): <u>4</u> Feet Below Land Surface	Other (specify): _____
Pumping Water Level (B): <u>35</u> Feet Below Land Surface	For flowing well, measured shut in head: _____ feet
Drawdown [(B) - (A)]: <u>4</u> Feet Below Land Surface	Well yielded <u>9</u> GPM with a drawdown of
Test Pumping Rate: <u>10</u> Gallons Per Minute	<u>4</u> feet after <u>7</u> hours of pumping
Duration of Pump Test (minimum 4 hours): <u>7</u> hours	

I HEREBY CERTIFY that the above statements are true to the best of my knowledge.

JOEL PIERCE 0-780 Joel Pi
 Print Name of Pump Installer and License No. (if applicable) Signature of Pump Installer

Form: OLWR-SWR-1B
RECEIVED
 FEB 20 2007
 BY: OLWR