

STATE WELL REPORT

Part 1

Driller's Log

Mississippi Department of Environmental Quality
Office of Land and Water Resources
P.O. Box 2309
Jackson, MS 39225-2309
(601)961-5210
(601)360-0535 (fax)

For Office Use Only:

Well #: D161
Aquifer: _____
E-Log #: _____

County: George
Permit #: _____
Driller: Michael S. Howard
Date drilling completed: 6/19/2013

State Law requires that this report be prepared by the license holder responsible for the work and filed with the Department at the above address within 30 days of completion of drilling of the well or borehole.

Well Owner Information <small>(Landowner if borehole is not for a water well)</small>	Well or Borehole Location
Owner Name: <u>Eddie Fleming (13017)</u>	Latitude: <u>30° 56' 40.47"</u> Longitude: <u>88° 31' 11.30"</u>
Mailing Address: <u>1192 Rocky Creek Road</u>	Method of Lat/Long (check one): Conventional Survey _____, USGS quad _____, Hand-held GPS _____, Survey-grade GPS _____
<u>Lucedale</u> MS <u>39152</u>	NW ¼ SE ¼, Sec 19 ✓ T T15 ✓ R R5W ✓
City State Zip Code	<u>3.5</u> Miles <u>East</u> of <u>Lucedale</u>
Telephone No. <u>(601) 508-6844</u>	(Distance) (Direction) (Nearest Town)

Well / Borehole Data
Date drilling started: <u>6/19/2013</u> Date drilling completed: <u>6/19/2013</u> Hole depth: <u>115'</u> Hole diameter: <u>7.5"</u>
Location of the source of any surface water used for drilling: _____
Method of dosing and volume of Chlorine used in drilling and development: _____
Logs run (circle all applicable): <u>No log run</u> Electric Gamma Ray Density Sonic Neutron Other: _____
Name of organization running log(s): _____
Purpose of borehole (circle one): <u>Water Well</u> Geotechnical/Geological Investigation Ground Source Heat Pump Seismic Survey Other (describe) _____
<i>If drilling is not related to water well construction, skip the remainder of this block</i>
Purpose of Well (circle all applicable): <u>Home</u> Industrial Public Supply Irrigation Fish Culture
Other (describe): _____
If a flowing well, method of flow regulation: Valve _____ Other (describe) _____
Static Water Level: <u>58</u> feet [above or <u>below</u> land surface (circle one)] Date measured: <u>6/20/2013</u>
Method of measurement (circle one): Steel tape <u>Electric tape</u> Air line Other (describe): _____
Well depth: <u>115'</u> Well grouted to a depth of: <u>12</u> feet Type of grout (circle one): Neat Cement Bentonite <u>Mix</u>
Casing length: <u>105'</u> feet Casing diameter: <u>4</u> inches Type of casing: <u>PVC 540 BE</u>
Screen length: <u>10</u> feet Screen diameter: <u>4</u> inches Type of screen: <u>WOP PVC 540</u>
Screen slot size: <u>.010</u> inches Setting depth: From <u>105'</u> feet to <u>115'</u> feet
Type of completion (circle all applicable): <u>Gravel packed</u> Underreamed Open hole Natural Development
Other (describe): _____
Top of lap pipe or reduction in casing: _____ feet
<i>If telescoped or more than one screen, describe on next page</i>

RECEIVED

JUN 19 2013


BY: OLWR

County: George
Permit #: _____

For Office Use Only:
Well #: D161

The sketch below only required for water wells


If well telescopes, show depths on sketch.

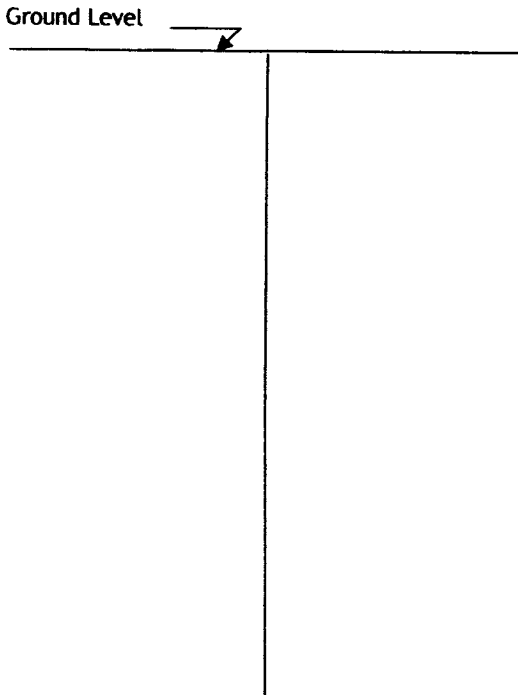

Description of formations encountered must be provided for all wells and boreholes, unless specifically exempted by regulations

Description of Formations Encountered	From (depth)	To (depth)
Topsand	Ground level	12'
Sand/silt	12'	35'
Clay	35'	42'
Sand	42'	68'
Sand	68'	115'

If more than one screen, show location of each on sketch

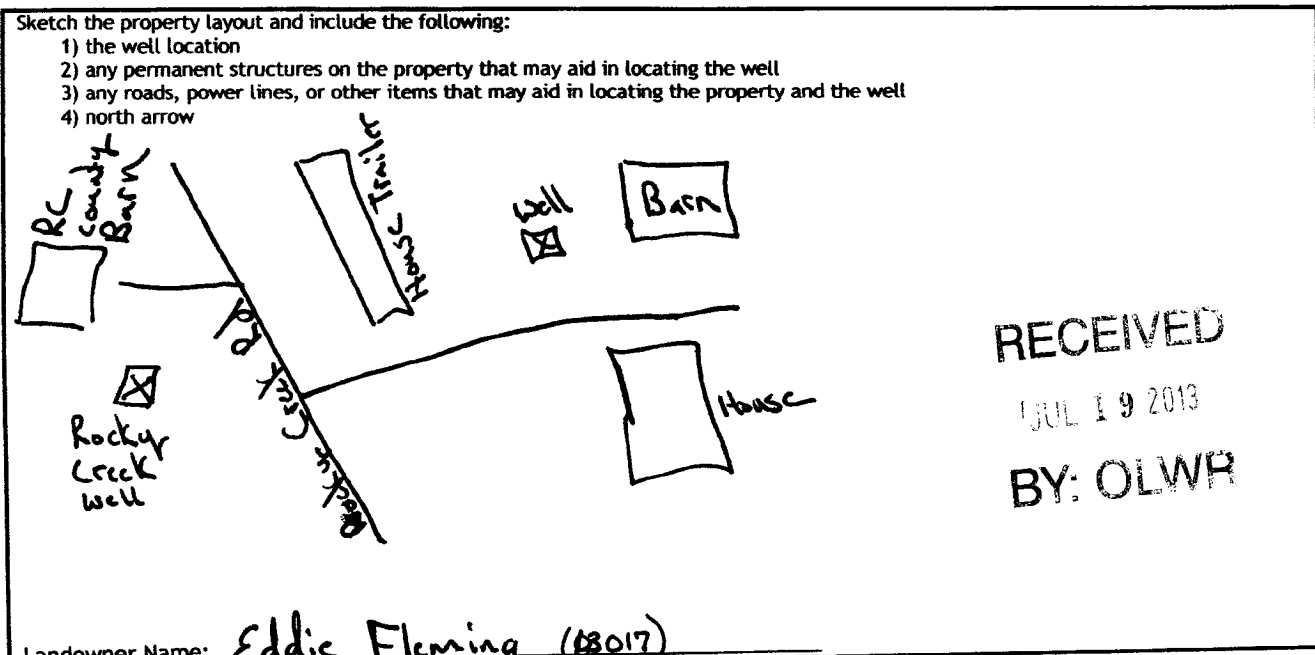

RECEIVED
JUL 19 2013
BY: OLWR

Landowner Name: Eddie Fleming (18017)

I HEREBY CERTIFY that the well/borehole was drilled, constructed, and completed in accordance with all applicable requirements of the Mississippi Department of Environmental Quality and the Mississippi Department of Health regulations, if applicable, and state laws.

Michael S. Havask 0-623 6-20-2013 Signature of Licensee

STATE WELL REPORT

Part 2

Pump Installer's Completion Report
 Mississippi Department of Environmental Quality
 Office of Land and Water Resources
 P.O. Box 2309
 Jackson, MS 39225-2309
 (601)961-5210
 (601) 360-0535 (fax)

County: George
 Permit #: _____
 Driller: Michael S. Havard
 Date completed: 6-20-2013
Copy information from block on Part 1

For Office Use Only:

Well #: D161
 Aquifer: _____

This part of the report must be completed by a licensed water well contractor or a licensed pump installer. A copy of Part 1 of the report must be attached and both parts filed with the Department at the above address within 30 days of well completion.

Well Owner Information	Well Location
Owner Name: <u>Eddie Fleming (13017)</u>	Latitude: <u>30°56'40.47</u> Longitude: <u>88°31'11.30</u>
Mailing Address: <u>1192 Rocky Creek Rd</u>	Method of Lat/Long (check one): Conventional Survey _____, USGS quad _____, Hand-held GPS _____, Survey-grade GPS _____
<u>Lucedale</u> MS <u>39452</u>	_____ ¼ _____ ¼, Sec <u>19</u> T <u>T1S</u> R <u>R5W</u>
City State Zip Code	<u>3.5</u> Miles <u>East</u> of <u>Lucedale</u>
Telephone No. (601) <u>508-6844</u>	(Distance) (Direction) (Nearest Town)

Pump Type (circle one)

Submersible Turbine Air Lift Centrifugal Flowing Well Jet Piston Rotary Other (describe): _____

Date Pump Installed: 6-20-2013 Rated Pump Capacity: 27 Gallons Per Minute

Is This Pump (circle one): New Repaired Replacement

Power Type (circle one)

Electric Diesel Gasoline Natural Gas Tractor PTO Windmill Other (describe): _____

Horse Power Rating of Motor: 1.5 Setting Depth: 103 feet Number of Stages: 10

Pump Test Data for Non Flowing Well

Date Well Tested: 6-20-2013 Duration of Pump Test (minimum 4 hours): 5 hours

Static Water Level (A): 58 Feet Below Land Surface Pumping Water Level (B): 80 Feet Below Land Surface

Drawdown [(B) - (A)]: 22 Feet Below Land Surface Test Pumping Rate: 35 Gallons Per Minute

Method of measurement (circle one): Steel tape Electric tape Air line Other (describe): _____

Pump Test Data for Flowing Well

Measured shut in head: _____ feet.

Well yielded _____ GPM with a drawdown of _____ feet after _____ hours of pumping

Meter Installation

Meter Manufacturer: _____ Meter Serial Number: _____

Meter Model Number/Name: _____ Type of Meter: _____

Totalizer Register Unit and Multiplier Factor (AF x .001, gal x 1000, etc): _____

Installation Date: _____ Meter installed by: _____

Is This Meter (circle one): New Repaired Replacement

RECEIVED
JUL 19 2013
BY: OLWR

Important: By submitting the above information you are certifying that this meter was installed to manufacturer standards. For agricultural wells, a list of approved meters is on the MDEQ website.

I HEREBY CERTIFY that the above statements are true to the best of my knowledge.

Michael S. Havard 0-673 6-20-2013 [Signature]
 Print Name of Pump Installer and License No. (if applicable) Date Signature of Pump Installer