

MISSISSIPPI DEPARTMENT OF ENVIRONMENTAL QUALITY

Office of Land and Water Resources

P. O. Box 10631
Jackson, MS 39289-0631
WATER WELL DRILLERS LOG

COUNTY WELL LOCATED <u>George</u>	
WELL NUMBER <u>D 2097</u>	CODED
DATE WELL COMPLETED <u>6-27-93</u>	

PERMIT NUMBER
NAME OF DRILLING FIRM <u>Pierce Well</u>

NAME & MAILING ADDRESS OF LANDOWNER <u>Alan Eubanks</u> <u>Dickerson Saw Mill Rd</u> <u>Rosedale, Ms</u>			
WELL LOCATION: SEC	TOWNSHIP	RANGE	
<u>3</u>	<u>1 S</u>	<u>5 E</u>	
DISTANCE	DIRECTION	NEAREST TOWN	
<u>1/2</u> Miles	<u>S</u> of	<u>Greene Co</u>	
OTHER LANDMARK			
WELL PURPOSE: Home, Irrigation, Municipal, Industrial, Fish Pond, etc.			

PUMP DATA		
PUMP TYPE (Circle One): <u>Submersible</u> Turbine, Jet, Flowing Well, Other (Describe)		
POWER TYPE (Circle One): <u>Electric</u> Tractor, Diesel, Gasoline, Butane, Other (Describe) <u>H/P 7/2</u>		
Pump Capacity (GPM)	No. of Stages	Setting Depth
<u>120</u>	<u>17</u>	<u>220</u> FT.
PUMP TEST		
Well yielded <u>100</u> GPM with a drawdown of <u>40</u> ft. after <u>1</u> hours of pumping		

WELL DATA		
Well Depth	Casing Diameter (In.)	Casing Length (Ft.)
<u>250</u>	<u>4"</u>	<u>230</u>
Type of Casing	Hole Depth	Depth to Static Water Level
<u>Plastic</u>	<u>250</u>	<u>100'</u>
TYPE OF COMPLETION: (Circle One or More): Gravel Packed, Underreamed, Telescoped, <u>Natural Development</u> , Open Hole, Other		

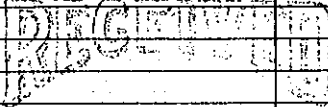
LOG DATA	
TYPE OF LOG RUN (Circle One): Electric, Gamma Ray, Density, Sonic, Neutron, Other (Describe) <u>No Log Run</u>	
Name of Organization Running Log	

WELL GROUTED TO A DEPTH OF <u>12</u> FEET
Type Grout (circle one): Cement, <u>Bentonite</u> , or Mix

GEOLOGIC DATA (Office Use Only)			
Surface Elev.	Geologic Unit	Unit Thickness	Depth to Top
Subs. SWL	Date	Analysis	Aquifer Test
Driller's Remarks			

SCREEN DATA		
Diameter - Inches	Length - Feet	Slot Size - Inches
<u>4"</u>	<u>20'</u>	<u>80/6</u>
Screen Type	Depth to Bottom - Feet	
<u>Plastic</u>	<u>250</u>	

DESCRIPTION OF FORMATIONS ENCOUNTERED	FROM	TO	FORMATIONS (Continued)	FROM	TO
<u>top soil</u>	<u>80</u>	<u>10</u>			
<u>clay</u>	<u>10</u>	<u>20</u>			
<u>sand</u>	<u>20</u>	<u>45</u>			
<u>clay</u>	<u>45</u>	<u>65</u>			
<u>sand</u>	<u>65</u>	<u>90</u>			
<u>clay</u>	<u>90</u>	<u>200</u>			
<u>good sand</u>	<u>200</u>	<u>250</u>			


 OCT 05 1993
 Dept. of Environmental Quality
 Office of Land & Water Resources

IF MORE SPACE IS NEEDED, USE BACK