

3 2

George
E8
4-67

MISSISSIPPI
BOARD OF WATER COMMISSIONERS
416 North State Street
Jackson, Mississippi 39201

CODED

WATER WELL DRILLERS LOG

4-10 1967 *Coast Water Well Dr. George*
date well completed firm name county well located

LANDOWNER: *Joyce Smith*
Janes, Miss
(mailing address)


description of formations encountered	from	to
<i>Red Clay</i>	<i>0</i>	<i>10</i>
<i>Sand Fine coarse</i>	<i>10</i>	<i>47</i>
<i>Blue Clay</i>	<i>47</i>	<i>136</i>
<i>Sand Fine - Med</i>	<i>136</i>	<i>157</i>

WELL LOCATION:
sec. *40* T. *2* N R. *8* E
S W
20 miles *West* of *Amite*
(distance) (direction) (nearest town)

WELL PURPOSE: *Camp*
(home, irrigation, municipal, industrial)

- WELL COMPLETION DATA:
- (1) diameter (inches) *2*
 - (2) total depth (feet) *157*
 - (3) static water level (feet) *10* ^{below} ~~above~~ top of ground.
 - (4) casing *Galv. 147'*
(material) (depth)
2"
(size) if telescope see back.
 - (5) screen *10'* *147'*
(length) (depth to top)
2" *Plastic*
(size) (material)
 - (6) pump *None* *300*
(HP) (yield gpm)
None
(type power)
 - (7) electric log *N O*
(yes or no)
- (organization running log)

CODED

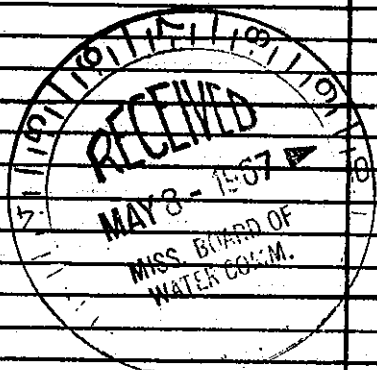

(8) how well bottom plugged
Best well labor

DRILLERS REMARKS: