

30

George
E9
6-67

MISSISSIPPI
BOARD OF WATER COMMISSIONERS
416 North State Street
Jackson, Mississippi 39201

WATER WELL DRILLERS LOG **CODED**

6-19 1967 HATTIESBURG BUTARE GEORGE
date well completed firm name county well located

LANDOWNER: RAY MOSS
STAR Route, Bendale, Miss
(mailing address)

description of formations encountered	from	to
Red sand	0	18
White sand	19	39
White clay	40	58
Blue clay	59	140
Grey clay	141	184
Blue clay	185	299
Blue sand	299	325


WELL LOCATION: NE SW
sec. 20 T-2 R-8 E
1 1/2 miles South of Store on Hwy 51
(distance) (direction) (nearest town)

WELL PURPOSE: HOME
(home, irrigation, municipal, industrial)

WELL COMPLETION DATA:

- (1) diameter (inches) 2"
- (2) total depth (feet) 325'
- (3) static water level (feet) 97' below top of ground.
- (4) casing GALV. PIPE 315' (material) (depth)
2" (size) if telescope see back.
- (5) screen 10" 315' (length) (depth to top)
2" BRONZE (size) (material)
- (6) pump 1 350 (HP) (yield gpm)
ELECTRIC (type power)
- (7) electric log NO (yes or no)
NO (organization running log)
- (8) how well bottom plugged BACK WASH VALVE

CODED

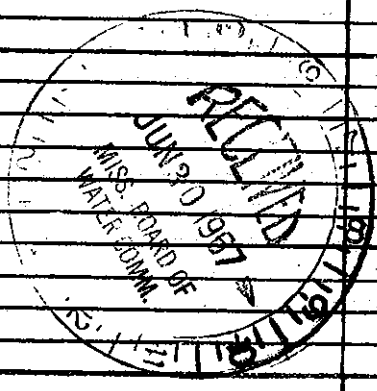

DRILLERS REMARKS: