

George
E58
6-3-81

MISSISSIPPI
BOARD OF WATER COMMISSIONERS
416 North State Street
Jackson, Mississippi 39201

CODED

WATER WELL DRILLERS LOG


6-3-81 date well completed 1981 Cecil S. Howells George Well name Service county well located

LANDOWNER: <u>Winston Hays</u> <u>Perkinson Hiss</u>	description of formations encountered	from	to
	Sand	0	2.3
	Sand + Gravel	2.3	31
	Blue Clay	31	197
	Sand + Gravel	197	210

WELL LOCATION:
sec 31 T 2 N R 8 E
5 miles NW of Bemdale
(distance) (direction) (nearest town)

WELL PURPOSE: camp
(home, irrigation, municipal, industrial)

- WELL COMPLETION DATA:
- (1) diameter (inches) 2"
 - (2) total depth (feet) 210
 - (3) static water level (feet) 1 below
above
top of ground
 - (4) casing Plastic 210
(material) (depth)
 - (size) if telescope see back.
 - (5) screen 10" 200
(length) (depth to top)
 - 2" Plastic
(size) (material)
 - (6) pump no pump 30
(HP) (yield gpm)
 - None
(type power)
 - (7) electric log
(yes or no)
 - (organization running log)
 - (8) how well bottom plugged Back
wash valve

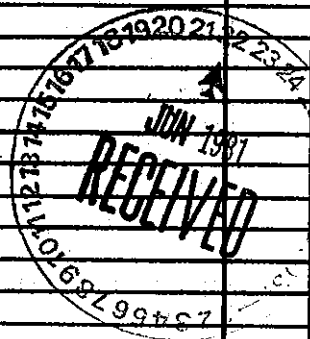

DRILLERS REMARKS: