
State W	ell Report	For Office Use Only		
County (1 1 1 1 1 1 1 1 1 1 1 1 1 1 1 1 1 1	art 1	For Office Use Only:		
Mississippi Department	t of Environmental Quality	Aquifer:		
	nd Water Resources Box 10631	Well #: E-122		
Drillet Cust Will Well SRV Jackson, M	IS 39289-0631	L. S. Elevation:		
The state of the s	961-5210	E land.		
(601) 35	4-6938 (fax)	E-log #:		
State Law requires that this report be prepared by the 30 days of completion of drilling of the well.	driller in detail and filed w	ith the Department within		
Well Owner Information	Well	Location		
Owner Name W.T. Smith	Latitude: 30° 50', 73	S' Longitude: <u>08° 45</u> ' <u>053</u> ''		
Mailing Address: River Bend Roxo	Method of Lat/Long (circle on	e): Conventional Survey,		
		GPS Survey-grade GPS		
Lucedale Ms 39452 City State Zip Code	10 18 Sec 40	Twn 725 Rng RgW		
Telephone No. (601)945-5207	Distance Direction H Miles	Nearest Town of Bin Date		
Well I)ata			
Purpose of Well (circle one) (Home) Industrial Public Supply		Other:		
Date well drilling started: 10-16-08 Date w		-16-08		
If flowing, method of flow regulation: Valve Other (de				
Static Water Level:flOWfeet above or below (circle one) le	and surface Date measured:_	10-16-08		
Method of Measurement (circle one) steel tape electric tape	air line other:			
Hole depth: 332 FT Well depth: 327 FT	Well grouted to a depth of	(Ofeet		
Type of grout (circle one): Cement Bentonite Mix				
Casing length: 317 feet Casing diameter: 2	inches Type of casing:	PVC		
Screen length: 10 feet Screen diameter: 2	inches Type of screen:	PVC		
Screen slot size:, OOO inches Setting depth: From	317feet to3	27_feet		
Type of completion (circle all applicable): Gravel packed Underreamed Telescoped Open hole Natural Development				
Other (describe):				
Top of lap pipe or reduction in casing: NA feet. If telescoped or more than one screen, describe on back of page				
Logs run (circle all applicable): No log run Electric Gamma Ray Density Sonic Neutron Other:				
Name of organization running log(s): NA I certify that the well was drilled, constructed, and completed in accordance with all applicable requirements of the Mississippi				
Department of Environmental Quality and/or the Mississippi Department of Health regulations and state laws.				
Tack Ridadail Ouisa		idadell		
JUCK Nagaell U-4 12		7		
Print Name of Water Well Contractor and License No.	Signature of	Water Well Contractor		
		RECEIVED		
		OCT 2 3 2008		
		BY: OLWR		
		- CAAL		

If well teles	copes please	sketch	below and	show	depths.
II WELLIEIES	AAHICS IIICASC	SKCLUII	OCIOW MIG	211044	oopus.

Ground Level		

Description of Formations Encountered TODSOIL Blue, Clay White Coarse Sand Blue, Clay W/Streaks Of Sand, Brown Medium to Coarse, Sand	From On Ogo	10 4377 10 4377
Tail Pipe	321	332

If more than one screen, show location of each on sketch

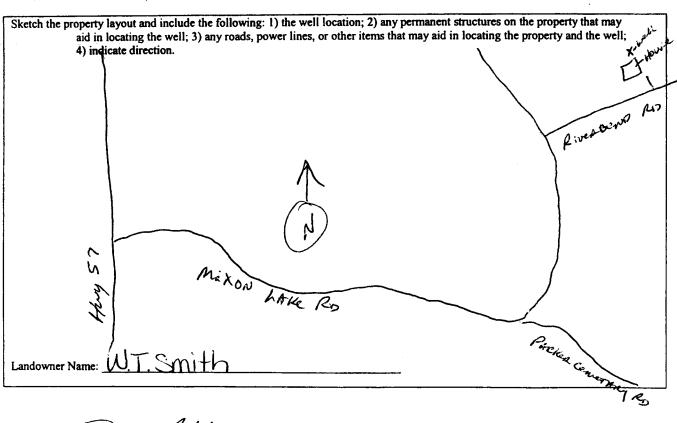

Signature of Water Well Contractor

RECEIVED

OCT 2 3 2008

BY: OLWR

STATE WELL REPORT				
County: George Permit #: Drille COST Water Wells RV Date completed: 10-14-08	Part 2 Pump Installer's Completion Report Mississippi Department of Environmental Quality Office of Land and Water Resources P.O. Box 10631 Jackson, MS 39289-0631 (601) 961-5210 (601) 354-6938 (fax)		For Office Use Only: Aquifer: Well #: £-/22 Elevation: The system of the system is a system of the system is a system of the system is a system of the system of the system is a system of the sys	
This report should be prepared by th installation of pump.	e pump installer in deta			
Well Owner Informat	ion		Location	
Owner Name: W.T. Smith	Latitude: 30° 50′ 732′′		Longitude: <u>088° 45′ 053</u> "	
Mailing Address: Riverbene	Method of Lat/Long (circle one		e): Conventional Survey,	
		USGS quad, (Hand	-held GPS Survey-grade GPS	
Lucedale, 1			Twn TS Rng RSW	
City State	Zip Code	Distance Direction		
Telephone No. (60) 945-5207 4 Miles 5F of Beautoake		Bernoste		
Pump Type Power Type			ver Tyme	
Pump Type Circle one			rcle one	
Air Lift Jet	Submersible	Diesel Engine Gasolin	e Engine Natural Gas	
Bucket Piston	Turbine	Electric Motor Hand	Tractor PTO	
Centrifugal Rotary	Flowing Well	Windmill Other (specify):	
Other (specify):	Horse Power Rating of Motor: 1/2HP		1/2HP	
Date Pump Installed: 10-17-08 Setting Depth: 30FT. Drop Pipe feet		OP PIPE feet		
Rated Pump Capacity:	Gallons Per Minute	Number of Stages:		
Pump Test Data Method of Measuring Water Level				
Date Well Tested: 10-17-08		Ci	rcle one	
Static Water Level (A): Flow Feet	Below Land Surface	Air Line Electric Meas	-	
Pumping Water Level (B): NA Feet	Below Land Surface	Other (specify):		
11/4-	Below Land Surface	For flowing well, measured sh	ut in head:feet	
			_GPM with a drawdown of	
Duration of Pump Test (minimum 4 hours):	4.5 hours	feet after	MA hours of pumping	

Signature of Pump Installer

I HEREBY CERTIFY that the above statements are true to the best of my knowledge.

Print Name of Pump Installer and License No. (if applicable)

RECEIVED

OCT 2 3 2008

BY: OLWR