
S	State Well	Report					
County: George	Part 1	•	For Office Use Only:				
Mississippi I		nvironmental Quality	Aquifer: E 130				
Permit #: Office	of Land and W P.O. Box 10		Well #:				
Driller: CLAST WITEY WEISKY	ackson, MS 392		L. S. Elevation:				
Date drilling completed: 12/3/09	(601) 961-5						
	(601) 354-693	8 (fax)	E-log #:				
State Law requires that this report be prepared by the driller in detail and filed with the Department within 30 days of completion of drilling of the well.							
Well Owner Information		Well Location					
Owner Name Heath Williams		Latitude: 30 · 50 · 239 " Longitude: 088 · 47 · 948 "					
Mailing Address: Ellen Branch Rd. M.		Method of Lat/Long (circle one): Conventional Survey,					
		USGS quad, Hand-held GPS Survey-grade GPS					
Lucedale ms 39452 City State Zip Code		Sw 1/Sw 1/4 Sec 28 wn 725 Rng R8W					
City State Zip Code NW NW 33 Distance Direction Miles South		Nearest Town of Rewaddle					
	Well Data						
Purpose of Well (circle one) Home Industrial Public	Supply Irrig	ation Fish Culture	Other:				
Date well drilling started: 12/3/09 Date well drilling completed: 13/9/09							
If flowing, method of flow regulation: Valve N/A Other (describe)							
Static Water Level: 40 feet above or below (circle one) land surface Date measured: 13/3/09							
Method of Measurement (circle one) steel tape electric tape air line other:							
Hole depth: 370 FT. Well depth: 370 FT. Well grouted to a depth of 10 feet							
Type of grout (circle one): Cement Bentonite Mix							
Casing length: (a) feet Casing diameter: (a) inches Type of casing: (b) C							
Screen length: 10 feet Screen diameter:	ainch	es Type of screen:	PVc.				
Screen slot size: 1004 inches Setting depti	h: From <u></u>	of feet to 3	TO feet				
Type of completion (circle all applicable): Gravel packet	l Underreamed	Telescoped Open	hole Natural Development				
Other (describ	oe):						
Top of lap pipe or reduction in casing:feet. If telescoped or more than one screen, describe on back of page							
Logs run (circle all applicable). No log run Electric Gamma Ray Density Sonic Neutron Other:							
Name of organization running log(s): N/A							
I certify that the well was drilled, constructed, and completed in accordance with all applicable requirements of the Mississippi							
Department of Environmental Quality and/or the Mississippi Department of Health regulations and state laws.							
Jack Ridgdell 0-472		Jul Ro	Spell 0-472				
Print Name of Water Well Contractor and License No.		Signature of V	ater Well Contractor				

If well telescopes please sketch below and show de	epths.	
Ground Level	Description of Formations Encountered	From To
Ground Devel	- Topsoil	0 2
	orange Clay	ર હ
	while course, sand	la a
	Blue Clay w/streaks of Sand	<b>a</b> 5 a5
	Gray Medium Sand	250a7
	,	
i i		<del></del>

If more than one screen, show location of each on sketch

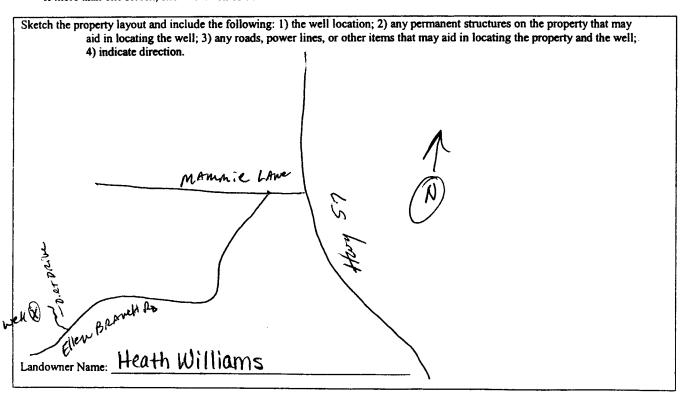

Signature of Water Well Contractor

## STATE WELL REPORT

## County: GEOrge Permit #: Driller Coast Water Well SRV. Date completed: 12/3/09

## Part 2

Pump Installer's Completion Report
Mississippi Department of Environmental Quality
Office of Land and Water Resources
P.O. Box 10631
Jackson, MS 39289-0631
(501) 961-5210

For Office Use Only:				
Aquifer:	E130			
Well #:				
Elevation:				

Date completed:	(601) 354-6938 (fax)		-	evadon.			
This report should be prepared by the pump installer in detail and filed with the Department within 30 days of the installation of pump.							
Well Owner Informat	ion		Well Lo				
Owner Name: HeathWilliams		Latitude: 20°50' 239" Longitude: 088" 47' 948"					
Mailing Address: Ellen Bro	Method of Lat/Long (circle one): Conventional Survey,						
		USGS qua	ad, (Hand-hel	d GPS, Surv	y-grade GPS		
Lucedale, Me	SW 1/2 SW 1/2 Sec 28 Twn T25 Rng R8W						
City State	Zip Code	Distance Direction Nearest Town					
Telephone No. (601) 947-032		JTH of	Benjaron	He_			
Pump Type Circle one			Power Circle		}		
Air Lift Jet	Submersible	Diesel Engine	Gasoline E	ngine	Natural Gas		
Bucket Piston	Turbine	Electric Motor	Hand		Tractor PTO		
Centrifugal Rotary	Flowing Well	Windmill		cify):			
Other (specify):		Horse Power Rating of Motor:					
Date Pump Installed: 12/4/09		Setting Depth: 40 FT. Droppipe feet					
Rated Pump Capacity:	Gallons Per Minute	Number of Stages:	2				
Pump Test Data  Date Well Tested: 2 4 9		Metho	d of Measur Circle	ing Water La	evel		
Static Water Level (A): 40 Feet	Ralow I and Surface	Air Line Elec	tric Measurir	ng Line	Steel Tape		
Pumping Water Level (B): N/A Feet I		Other (specify):					
Drawdown [(B) – (A)]: Feet		For flowing well, mea	sured shut in	head:	A feet		
·^	Gallons Per Minute	Well yielded 23		M with a dra			
Duration of Pump Test (minimum 4 hours):	hours	MA fee	t after	,	rs of pumping		
I HEREBY CERTIFY that the above statement	ents are true to the best of	my knowledge					
Jack Ridadell 0-472							
Print Name of Pump Installer and License N	o. (if applicable)	Signature of					