STATE WELL REPORT					
County: George Permit #:	D Mississippi Departa Office of La Jacksa ((60 be prepared by the ithin 30 days of con ion a water well)	Part 1 riller's Log ment of Environmental Quality nd and Water Resources P.O. Box 2309 on, MS 39225-2309 601)961-5555 1)961-5228 (fax) license holder responsible for the mpletion of drilling of the well of	elev 190 he work and filed win or borehole. hole Location gitude: <u>-88.821</u>	RECEIVED 03-09-2022 th the By OLWF 2830	
Lucedale Ms City State Telephone No. ()	39452 Zip Code	USGS quad, Hand-held G <u>SE</u> ¼ <u>SE</u> ¼, Sec <u>1.1</u> Miles <u>NW</u> (Distance) (Direction)	7	_R 8W	
Well / Borehole Data Date drilling started: 03/01/2022 Date drilling completed: 03/01/2022 Hole depth: 60 Hole diameter: 4 1/2					
Date dritting started. Date dritting completed. Hole depth. Date dritting completed. Location of the source of any surface water used for drilling:					
	-	describe) onstruction, skip the remainder			
Purpose of Well (check all applicable): Other (<i>describe</i>): If a flowing well, method of flow regul Static Water Level: <u>40</u> feet	Home Industria	l Public Supply Irrigation Other (<i>describe</i>)	Fish Culture		
Method of measurement (check one): Well depth: 60 Well grouted to a Casing length: 55 feet Ca Screen length: 5 feet S Screen slot size: .08 inches Type of completion (check all applicable Other (describe):	depth of: <u>10</u> f asing diameter: <u>2</u> creen diameter: <u>2</u> Setting depth: <i>e</i>): Gravel packed	eet Type of grout (check <i>one</i>): inches Type of c inches Type of s From <u>55</u> feet to Underreamed Open hole	Neat Cement Bento asing: <u>Wrap</u> screen: <u>Wrap</u> <u>60</u> Natural Developmo	onite Mix	
Top of lap pipe or reduction in casing:feet					
If telescoped or more than one screen, describe on next page					

	_		
County: George			
Permit #:			

RECEIVED 03-09-2022 **BY OLWR**


For Office Use Only:

Well #: _____E159

Description of formations encountered must be provided for all wells and boreholes, unless specifically exempted by regulations

If well telescopes, show depths on sketch.

The sketch below only required for water wells

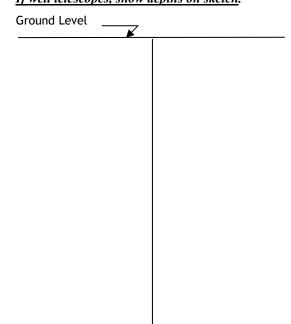

Description of Formations Encountered	From (depth)	To (depth)
Mix clay	Ground level	15
Clay	15	28
Sand	28	60

If more than one screen, show location of each on sketch

Sketch the property layout and include the following:

1) the well location

2) any permanent structures on the property that may aid in locating the well

3) any roads, power lines, or other items that may aid in locating the property and the well

4) north arrow

