

E2011

George
E 2011
4-2-81

MISSISSIPPI
BOARD OF WATER COMMISSIONERS
416 North State Street
Jackson, Mississippi 39201

WATER WELL DRILLERS LOG

4/2/81 date well completed 1981
81 Cecil S. Howells Water Well Ser. George county well located


LANDOWNER: Willie T Gardner
Ray Miss
(mailing address)

WELL LOCATION:
sec 28 T 2 N R 8 E
6 miles N of Blendale
(distance) (direction) (nearest town)

WELL PURPOSE: Home
(home, irrigation, municipal, industrial)

- WELL COMPLETION DATA:
- (1) diameter (inches) 2"
 - (2) total depth (feet) 260
 - (3) static water level (feet) 19 (below/above top of ground)
 - (4) casing Plastic 260
(material) (depth)
 - (5) screen 5 ft 255
(length) (depth to top)
2" Plastic
(size) (material)
 - (6) pump 3/4 5
(HP) (yield gpm)
Electric
(type power)
 - (7) electric log
(yes or no)

description of formations encountered	from	to
Dirt	0	2
Red dirt	2	10
Red clay	10	16
Dark sand	16	21
Blue clay	21	157
Dark sand	157	163
Blue clay	163	241
Sand & Shale	241	260

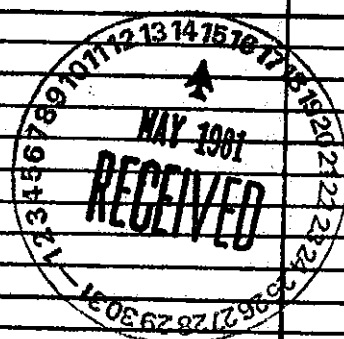

(organization running log)
(8) how well bottom plugged Back Wash Valve

DRILLERS REMARKS: